


STATE OF KANSAS
STATE CORPORATION COMMISSION

WELL PLUGGING RECORD

Give All Information Completely
Make Required Affidavit
Mail or Deliver Report to:
Conservation Division
State Corporation Commission
211 No. Broadway
Wichita, Kansas

Pratt County, Sec. 6 Twp. 27 Rge. 15 (E) W (W)

NORTH

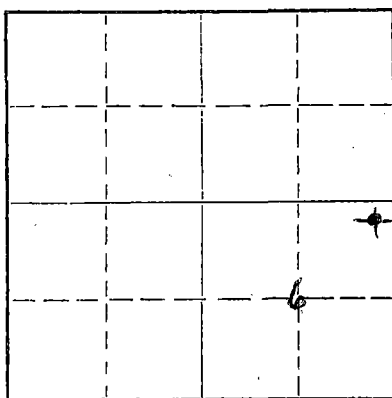

Locate well correctly on above
Section Plat

Location as "NE/CNW&SW&" or footage from lines NE NE NE
Lease Owner Sam P. Wallingford, Inc.
Lease Name Tatlock Well No. 1
Office Address Wichita, Kansas
Character of Well (completed as Oil, Gas or Dry Hole) Dry Hole
Date well completed 5-12 1962
Application for plugging filed 5-14 1962
Application for plugging approved 5-16 1962
Plugging commenced 5-26-62 1962
Plugging completed 6-1-62 1962
Reason for abandonment of well or producing formation Depleted, D & A

If a producing well is abandoned, date of last production None 1962
Was permission obtained from the Conservation Division or its agents before plugging was commenced? yes

Name of Conservation Agent who supervised plugging of this well Fred Hample
Producing formation _____ Depth to top _____ Bottom _____ Total Depth of Well 4843 Feet
Show depth and thickness of all water, oil and gas formations.


OIL, GAS OR WATER RECORDS

CASING RECORD

| FORMATION | CONTENT | FROM | TO | SIZE | PUT IN | PULLED OUT |
|---------------------|--------------|------|------|--------|--------|------------|
| Brown Lime | | 3968 | 3985 | 8-5/8" | 850' | None |
| Lansing-Kansas City | | 3985 | 4430 | 4-1/2" | 4550' | 3356' |
| Mississippian | Sl. show gas | 4435 | 4460 | | | |
| Viola | | 4537 | 4708 | | | |
| Simpson | | 4708 | 4799 | | | |
| Arbuckle | | 4799 | 4843 | | | |

Describe in detail the manner in which the well was plugged, indicating where the mud fluid was placed and the method or methods used in introducing it into the hole. If cement or other plugs were used, state the character of same and depth placed, from _____ feet to _____ feet for each plug set.

Checked hole to 4519', sanded to 4420' and dumped 4 sacks of cement @ 4420' with dump ka bailer. Pulled 4 1/2" casing, bailed mud to 300', set rock bridge to 290' and ran 20 sacks of cement. Mudded to 40', set rock bridge to 30' and ran 10 sacks of cement to base of cellar.

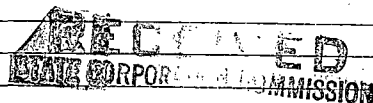

PLUGGING COMPLETE.

JUN 11 1962
06-11-62
CONSERVATION DIVISION
Wichita, Kansas

Name of Plugging Contractor KNIGHT CASING PULLING COMPANY
Address CHASE, KANSAS

STATE OF KANSAS, COUNTY OF RICE, ss.
Noel J. Knight (employee of owner) or XXXXXXXXXXXX (owner or operator) of the above-described well, being first duly sworn on oath, says: That I have knowledge of the facts, statements, and matters herein contained and the log of the above-described well as filed and that the same are true and correct. So help me God.

(Signature) Noel J. Knight
Chase, Kansas
(Address)

SUBSCRIBED AND SWORN TO before me this 2nd day of June, 1962

My commission expires May 20, 1964

Milton J. Volin Notary Public.

INVOICED

DATE 6/11/62
INV. NO. 5149-w