


STATE OF KANSAS
STATE CORPORATION COMMISSION

WELL PLUGGING RECORD

Give All Information Completely
Make Required Affidavit
Mail or Deliver Report to:
Conservation Division
State Corporation Commission
211 No. Broadway
Wichita, Kansas

Pratt County. Sec. 3 Twp. 27S Rge. (E) 15 (W)
Location as "NE/CNW/SW" or footage from lines G SE/4 NE/4
Lease Owner Tennessee Gas Transmission Company
Lease Name Luther W. Stotts Well No. 1
Office Address P. O. Box 163 - Great Bend, Kansas
Character of Well (completed as Oil, Gas or Dry Hole) Dry Hole
Date well completed 9-2 1957
Application for plugging filed 9-3 1957
Application for plugging approved 9-2 1957
Plugging commenced 9-2 1957
Plugging completed 9-2 1957
Reason for abandonment of well or producing formation _____

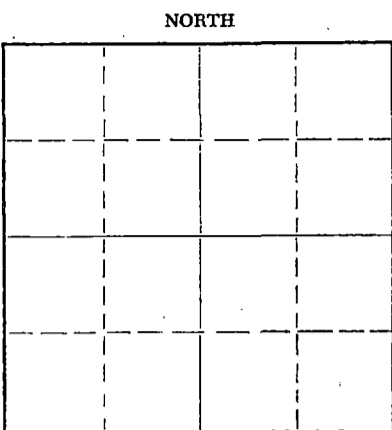

Locate well correctly on above
Section Plat

If a producing well is abandoned, date of last production _____ 19____
Was permission obtained from the Conservation Division or its agents before plugging was commenced? Yes

Name of Conservation Agent who supervised plugging of this well M. A. Rives
Producing formation _____ Depth to top _____ Bottom _____ Total Depth of Well 4663 Feet
Show depth and thickness of all water, oil and gas formations.

OIL, GAS OR WATER RECORDS

CASING RECORD

FORMATION	CONTENT	FROM	TO	SIZE	PUT IN	PULLED OUT
				8-5/8"OD	326	None

Describe in detail the manner in which the well was plugged, indicating where the mud fluid was placed and the method or methods used in introducing it into the hole. If cement or other plugs were used, state the character of same and depth placed, from _____ feet to _____ feet for each plug set.

Filled hole w/heavy mud to 300'
Set plug at 300' w/1/3 sack hulls and 20 sacks cement on top of plug.
Filled w/mud to 35'.
Set plug at 35' w/1/3 sack hulls and 10 sacks cement on top of plug.

Comp. 11:00 A.M. 9-2-57

RCVD
09-07-57
STATE CORPORATION COMMISSION
SEP 7 1957
CONSERVATION DIVISION
Wichita, Kansas

(If additional description is necessary, use BACK of this sheet)
Name of Plugging Contractor Strata Drilling Company
Address 10th & O'Dell - Great Bend, Kansas

STATE OF Kansas, COUNTY OF Rice, ss.
Glen E. Armour (employee of owner) ~~owner or operator~~ of the above-described well, being first duly sworn on oath, says: That I have knowledge of the facts, statements, and matters herein contained and the log of the above-described well as filed and that the same are true and correct. So help me God.

(Signature) Glen E. Armour

(Address)

SUBSCRIBED AND SWORN TO before me this 3rd day of September, 1957

Vincent O. Gray
Notary Public.

My commission expires May 20, 1958

PLUGGING
FILE SEC 3 T 27 R 15W
BOOK PAGE 42 LINE 10

D R I L L E R S L O G

#1 LUTHER W. STOTTS

CASING RECORD:
326' of new 8-5/8"
at 326'.

COMPANY: Tennessee Gas
Transmission Co.

LOCATION: C SE NE
Sec. 3-27S-15W
Pratt County,
Kansas

CONTRACTOR: STRATA DRILLING, INC.

COMMENCED: August 17, 1957
COMPLETED: September 2, 1957

ELEVATION:

TOTAL DEPTH: 4663'

D. & A.

FORMATION	FROM	TO	REMARKS
Sand and Shell	0	300	
Red Bed	300	1000	
Sand	1000	1050	
Red Bed and Shale	1050	1360	
Shale and Shell	1360	2055	
Lime and Shale	2055	3540	
Lime	3540	3775	
Lime and Shale	3775	3865	
Lime	3865	4290	
Lime and Shale	4290	4360	
Lime	4360	4663	Electric Log

TOTAL DEPTH 4658' KB

I certify that this is a true and correct copy of the above log to the best of my knowledge.

STRATA DRILLING, INC.

Charles W. Steincamp
Charles W. Steincamp, President

Subscribed and sworn to before me this 22th day of October, 1957.

Robert E. Southern
Notary Public

My Commission Expires:
November 9, 1959

STATE OF KANSAS)
) S.S.
COUNTY OF BARTON)

FILED
OCT 24 1957
CONSERVATION DIVISION
Wichita, Kansas

PLUGGING
FILE SEC 3 T 27 R 15W
BOOK PAGE 42 LINE 10