15-151-00171-00-00

STATE OF KANSAS
STATE CORPORATION COMMISSION

Give All Information Completely
Make Required Affidavit
Mail or Deliver Report to:
Conservation Division
State Corporation Commission
800 Bitting Building
Wichita, Kansas

WELL PLUGGING RECORD
OR
FORMATION PLUGGING RECORD

Strike out upper line when reporting plugging off formations.

NORTH

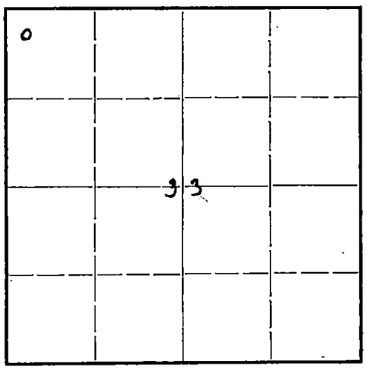

Locate well correctly on above Section Plat

Pratt County. Sec. 33 Twp. Rge 27S (E) 13 (W)

Location as "NE¼NW¼SW¼" or footage from lines NW/4 NW/4

Lease Owner Paul Hatfield et al

Lease Name Lemon Well No. 1

Office Address 919 Union National Bank Building

Character of Well (completed as Oil, Gas or Dry Hole) Dry

Date well completed 8 - 2 1944

Application for plugging filed 8 - 3 1944

Application for plugging approved 8 - 3 1944

Plugging commenced 8 - 3 1944

Plugging completed 8 - 3 1944

Reason for abandonment of well or producing formation

If a producing well is abandoned, date of last production 19

Was permission obtained from the Conservation Division or its agents before plugging was commenced? Yes

Name of Conservation Agent who supervised plugging of this well Eldon Petty

Producing formation Depth to top Bottom Total Depth of Well Feet

Show depth and thickness of all water, oil and gas formations.

OIL, GAS OR WATER RECORDS

CASING RECORD

Formation	Content	From	To	Size	Put In	Pulled Out
				10 3/4	255'	none

Describe in detail the manner in which the well was plugged, indicating where the mud fluid was placed and the method or methods used in introducing it into the hold. If cement or other plugs were used, state the character of same and depth placed, from feet to feet for each plug set.

Filled with mud from 4580' to 255'
Set plug at 255'
20 sax cement on top of plug
Mud to 25'
Set plug at 25'
10 sax cement on top of plug

PLUGGING
FILE 33 27-13W
BOOK 127 PAGE 6

(If additional description is necessary, use BACK of this sheet)

Correspondence regarding this well should be addressed to Hinkle Oil Company

Address 919 Union National Bank Building, Wichita, Kansas.

STATE OF Kansas, COUNTY OF Sedgwick, ss.

J. B. Hinkle (employee of owner) or (owner or operator) of the above-described well, being first duly sworn on oath, says: That I have knowledge of the facts, statements, and matters herein contained, and the log of the above-described well as filed and that the same are true and correct. So help me God.

STATE CORPORATION COMMISSION
AUG - 5
CONSERVATION DIVISION

08-05-44

(Signature)

919 Union National Bank Building
(Address)

SUBSCRIBED AND SWORN TO before me this 4th day of August, 19 44

Muriel A. Upton
Notary Public.

My commission expires January 17, 1946

20-1300-s 11-43—10M