


STATE OF KANSAS  
STATE CORPORATION COMMISSION

Form CP-4

WELL PLUGGING RECORD

Give All Information Completely  
Make Required Affidavit  
Mail or Deliver Report to:  
Conservation Division  
State Corporation Commission  
211 No. Broadway  
Wichita, Kansas

NORTH

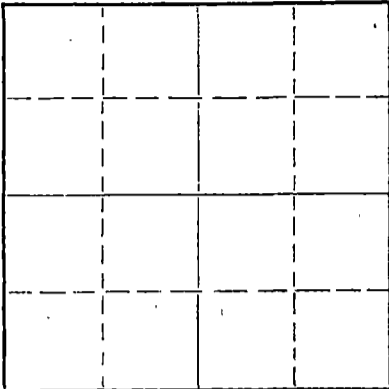

Locate well correctly on above  
Section Plat

Pratt County, Sec. 33 Twp 27 S Rge. 13 ~~XXX~~ (W)  
Location as "NE/CNW/SW" or footage from lines NE/4 SE/4 NW/4  
Lease Owner Messman-Rinehart Oil Company  
Lease Name Limon (Washdown) Well No. 1  
Office Address 1432 Wichita Plaza Bldg., Wichita, Kansas  
Character of Well (completed as Oil, Gas or Dry Hole) Dry  
Date well completed January 19 1964  
Application for plugging filed Jan. 24 ~~Rock~~ 1964  
Application for plugging approved Jan. 27 ~~Rock~~ 1964  
Plugging commenced Feb II 1964  
Plugging completed Feb 14 1964  
Reason for abandonment of well or producing formation Dry

If a producing well is abandoned, date of last production \_\_\_\_\_ 19\_\_\_\_  
Was permission obtained from the Conservation Division or its agents before plugging was commenced? Yes

Name of Conservation Agent who supervised plugging of this well Archie Erving  
Producing formation \_\_\_\_\_ Depth to top \_\_\_\_\_ Bottom \_\_\_\_\_ Total Depth of Well 4355 Feet  
Show depth and thickness of all water, oil and gas formations.

OIL, GAS OR WATER RECORDS

CASING RECORD

FORMATION	CONTENT	FROM	TO	SIZE	PUT IN	PULLED OUT
				4"	4355'	2509'
				8 5/8"	363'	none

Describe in detail the manner in which the well was plugged, indicating where the mud fluid was placed and the method or methods used in introducing it into the hole. If cement or other plugs were used, state the character of same and depth placed, from \_\_\_\_\_ feet to \_\_\_\_\_ feet for each plug set.

Plugged off bottom of hole with rock. Rock from 4313' to 4280'. Dumped 3 sx of cement. Mudded hole to 300'. Made 10' of rock bridge. Dumped 25 sx of cement. Mudded hole to 40'. Made 10' of rock bridge. Dumped 10 sx of cement, filling to the bottom of the celler.

RECEIVED  
STATE CORPORATION COMMISSION

FEB 24 1964  
02-24-64  
CONSERVATION DIVISION  
Wichita, Kansas

(If additional description is necessary, use BACK of this sheet)

Name of Plugging Contractor Art Lamb Casing Pulling Co.  
Address P.O. Box 983 Hutchinson, Kansas

STATE OF Kansas, COUNTY OF Reno, ss. Art Lamb (employee of owner) or (owner or operator) of the above-described well, being first duly sworn on oath, says: That I have knowledge of the facts, statements, and matters herein contained and the log of the above-described well as filed and that the same are true and correct. So help me God.

(Signature) [Signature]  
2809 Kings Dr. Hutchinson, Kansas  
(Address)

SUBSCRIBED AND SWORN TO before me this 17 th day of February 19 64

My commission expires January 5, 1966

[Signature]  
Notary Public.

COMPLETION DATA

Messman-Rinehart Oil Company  
No. 1 Lemon (Washdown)  
NE/4 SE/4 NW/4, Sec. 33-27S-13W  
Pratt County, Kansas

- 1/6/64 - Moved in cable tools, Perf. 4290-98 ft. w/4<sup>5</sup> ft.,  
Treated w/400 gal. mud acid, pressured up to 500#,  
on vacuum
- 1/7/64 - Sub. hole down, tested 200,000 cubic feet of gas plus  
2 bbls. water per hr., shut down for 14 hrs.
- 1/9/64 - Filled up 19 bbls. wtr. (esti. 1½ bbls. wtr. per hr.  
and 100,000-200,000 cubic feet of gas  
analysis of water shows it to be Mississippian Formation  
wtr., pulling tbg..

Preparing to abandon - 1/19/64

MESSMAN-RINEHART OIL COMPANY

By: 

Roger L. Messman

RLM/bjs  
2/21/64