

15-191-00662-0980
WELL PLUGGING RECORD

Give All Information Completely
Make Required Affidavit
Mail or Deliver Report to:
Conservation Division
State Corporation Commission
211 No. Broadway
Wichita, Kansas

Sumner

County. Sec. 27 Twp. 32S Rge. 2E (E) (W)

Location as "NE/CNW/SW" or footage from lines SE SW SW

Lease Owner McNeish & Gralapp

Lease Name KNAPP Well No. 1

Office Address 528 State Bank Bldg., Winfield, Kans.

Character of Well (completed as Oil, Gas or Dry Hole) DRY

Date well completed 1/5 1958

Application for plugging filed 1/5 1958

Application for plugging approved 1/5 1958


Plugging commenced 1/5 1958

Plugging completed 1/5 1958

Reason for abandonment of well or producing formation _____

If a producing well is abandoned, date of last production _____ 19____

Was permission obtained from the Conservation Division or its agents before plugging was commenced? yes

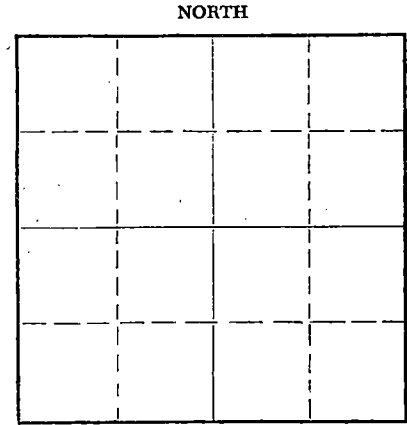

Locate well correctly on above Section Plat

Name of Conservation Agent who supervised plugging of this well Gene Graham

Producing formation _____ Depth to top _____ Bottom _____ Total Depth of Well 3371 Feet

Show depth and thickness of all water, oil and gas formations.

OIL, GAS OR WATER RECORDS

CASING RECORD

FORMATION	CONTENT	FROM	TO	SIZE	PUT IN	PULLED OUT

Describe in detail the manner in which the well was plugged, indicating where the mud fluid was placed and the method or methods used in introducing it into the hole. If cement or other plugs were used, state the character of same and depth placed, from 3371 feet to 0 feet for each plug set.

Heavy mud from 3371 ft. T.D. to 240 ft.; 15 sacks cement;
heavy mud to 40 ft.; cement to top of surface casing;
steel plug welded on surface.

RECEIVED
STATE CORPORATION COMMISSION

JAN 16 1958

CONSERVATION DIVISION
Wichita, Kansas

(If additional description is necessary, use BACK of this sheet)
Name of Plugging Contractor Watson Drilling Co., Winfield, Kans.
Address 528 State Bank Bldg.

STATE OF Kansas COUNTY OF Cowley, ss.
Geo. T. McNeish, one of operators (employee of owner) or (owner or operator) of the above-described well, being first duly sworn on oath, says: That I have knowledge of the facts, statements, and matters herein contained and the log of the above-described well as filed and that the same are true and correct. So help me God.

(Signature) Geo. T. McNeish
Winfield, Kans. (Address)

SUBSCRIBED AND SWORN TO before me this 13th day of January, 19 58

My commission expires April 9, 1960

Grace Hill
Notary Public.

PLUGGING
FILE SEC. 27 T. 32 R. 25
BOOK PAGE 76 LINE 9

WELL LOG

Company: McNeish & Gralapp
Winfield, Kan.

KNAPP #1
SE SW SW Sec. 27-32S-2E
Sumner County, Kan.

Contractor: Watson Drilling Co., Inc.
Winfield, Kan.

DRY & ABANDONED

Comm: 12-23-57
Comp: 1-5-58

Casing Record:
208 ' of 8 5/8" surface casing.

Surface clay & shale & lime	0	208
shale & lime	208	525
shale & shells	525	555
lime	555	585
shale & lime	585	1060
shale & shells	1060	1305
shale & lime	1305	1510
lime	1510	1555
shale & lime	1555	1850
lime	1850	1895
shale & lime	1895	1919
shale & sand	1919	1938
shale & lime	1938	1964
shale	1964	2043
lime & shale	2043	2174
sand & shale	2174	2263
shale	2263	2323
shale & lime	2323	2335
shale	2335	2388
sand & shale	2388	2470
sand	2470	2474
shale	2474	2532
sand & shale	2532	2556
shale	2556	2788
lime	2788	2793
sand	2793	2807
lime & shale	2807	2823
sand & shale	2823	2841
lime K.C.	2841	2900
lime & shale	2900	2973
lime	2973	2997
lime & shale	2997	3122
lime	3122	3167
lime & shale	3167	3326
shale	3326	3358
chat Mississippi	3358	3371

RECEIVED
STATE CORPORATION COMMISSION

JAN 16 1958

CONSERVATION DIVISION
Wichita, Kansas

T. D. 3371'

PLUGGING
SEC. 27 T. 32 R. 2 E
BOOK PAGE 76 LINE 9