


15-175-00122-0000

15-175-00122 00-00

STATE OF KANSAS  
STATE CORPORATION COMMISSION  
CONSERVATION DIVISION  
P. O. BOX 17027  
WICHITA, KANSAS 67217

FORM CP-4

WELL PLUGGING RECORD

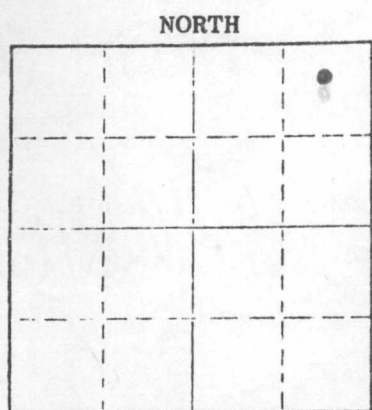

Locate well correctly on above Section Plat

Seward County, Sec. 7 Twp. 33S Rge. 33 (E) (W) X

Location as "NE/CNW&SW¼" or footage from lines C NE NE

Lease Owner Hasada Indstres

Lease Name March Well No. 1

Office Address Box 782 Liberal, Kansas 67901

Character of Well (completed as Oil, Gas or Dry Hole)

Date well completed 10-1 1963

Application for plugging filed 9-15 1975

Application for plugging approved 10-30 1975

Plugging commenced 11-7 1975

Plugging completed 11-8 1975

Reason for abandonment of well or producing formation non commercial

If a producing well is abandoned, date of last production 19

Was permission obtained from the Conservation Division or its agents before plugging was commenced? Yes

Name of Conservation Agent who supervised plugging of this well Clarence Thomas

Producing formation Depth to top Bottom Total Depth of Well 6374 Feet

Show depth and thickness of all water, oil and gas formations.


OIL, GAS OR WATER RECORDS

CASING RECORD

FORMATION	CONTENT	FROM	TO	SIZE	PUT IN	PULLED OUT
St Louis	oil	6228	6240	8 5/8	1595	none
				5 1/2	6250	2700

Describe in detail the manner in which the well was plugged, indicating where the mud fluid was placed and the method or methods used in introducing it into the hole. If cement or other plugs were used, state the character of same and depth placed, from feet to feet for each plug set.

Pump 15 sks. of cement @ 6374 to 6000  
Pump 35 sks. of cement @ 1200 to 1100  
Pnt 15 sks. of cement @ 45 to 0

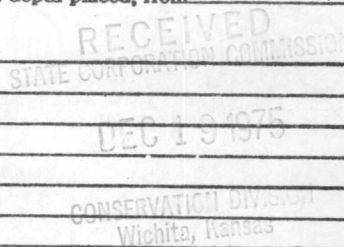

(If additional description is necessary, use BACK of this sheet)

Name of Plugging Contractor Sargent's Casing Pulling Service Kansas No. 511

Address Box 506 Liberal, Kansas 67901


STATE OF Kansas COUNTY OF Seward ss.

Hasada Industries (employee of owner) or (owner or operator) of the above-described well being plugged on oath, says: That I have knowledge of the facts, statements, and matters herein contained and the log of the above-described well as filed and that the same are true and correct. So help me God.

(Signature) H. E. Boy

to before me this 15th day of Dec. 1975 (Address)

My commission expires 11-25-79 Notary Public.

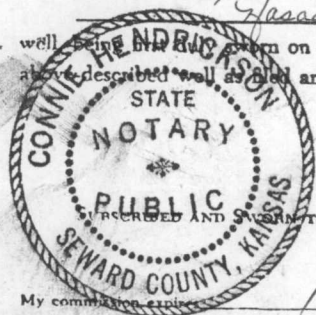

STENCILED

DEC 3 1966

15-175-00122 ORIGINAL  
 KANSAS GEOLOGICAL SOCIETY  
 KANSAS WELL LOG BUREAU - KANSAS WELL SAMPLE BUREAU  
 KANSAS GEOLOGICAL SOCIETY BUILDING  
 508 EAST MURDOCK - WICHITA, KANSAS

COMPANY FALCON SEABOARD DRLG.

SEC. 7 T. 33 R. 33W

LOC. CNE NE

FARM March

NO. 1

COUNTY Seward

TOTAL DEPTH 6375'


COMM. 7-24-63

COMP. 10-10-63

SHOT OR TREATED

CONTRACTOR Falcon Seaboard Drlg.

ISSUED 12-3-66

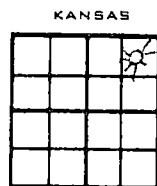

CASING

20	10	
15	8 5/8	1573'
12	6	
13	5 1/2	6372'

ELEVATION 2833' KB

PRODUCTION 4 PT OF  
 1,100,000 CFGPD (Chest  
 6054-6150) Pmp. 115  
 BOPD & 10 BW (St. Lou  
 6228-40)

FIGURES INDICATE BOTTOM OF FORMATIONS

COMPLETE DRILLERS LOG NOT AVAILABLE.

TOPS: SCOUT

Heebner	4150
Toronto	4189
Lansing	4308
Marmaton	4996
Cherokee	5154
Morrow	5560
Chester	5824
Chester Sand	6053
St. Genevieve	6092
St. Louis	6228

Log Tops:

Heebner	4166	(-1333)	
Tor	4188	(-1355)	
Lans	4308	(-1475)	
Marm	4992	(-2159)	
Mor	5560	(-2727)	
SD	5668	(-2835)	0/29
S3	5764	(-2931)	2/19
Ches	5784	(-2951)	
SD	5946	(-3113)	3/18
SD	6039	(-3206)	10/30TG
Ste Gen	6110	(-3277)	
St Lo	6220	(-3386)	

15' porosity over tested interval.

Lower porous zones indicate water

DST 6220-66, prob. St. Louis, op 2 hrs  
 Gd blo, GTS 68", rec. 100' HOCM,  
 370' oil, 160' MW,  
 FP 50-149, ISIP 1995/30, FSIP 1975/45

DST 6054-84, op 2 hrs, GTS 13 min  
 76 MCF/5 min, 116/2 hrs,  
 rec. 30 ft, GCM, FP 56-77,  
 ISIP 1917/30 min, FSIP 1948/45  
 min.  
 Drlg. 6148

*[Faint handwritten notes and stamps]*  
 DEC 3 1966  
 KANSAS GEOLOGICAL SOCIETY