

15-175-10003-0000


15-175-10003-0000

STATE OF KANSAS
STATE CORPORATION COMMISSION

Form CP-4

Give All Information Completely
Make Required Affidavit
Mail or Deliver Report to:
Conservation Division
State Corporation Commission
211 No. Broadway
Wichita, Kansas

WELL PLUGGING RECORD

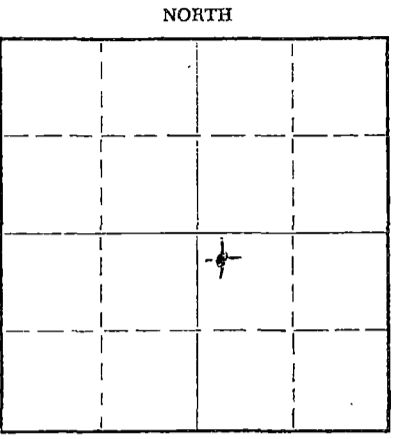

Locate well correctly on above Section Plat

Seward County. Sec. 9 Twp. 33S Rge. (E)33W (W)
Location as "NE/CNW%SW%" or footage from lines C NW SE
Lease Owner Anadarko Production Company
Lease Name Browne "A" Well No. 1
Office Address Box 351 Liberal, Kansas
Character of Well (completed as Oil, Gas or Dry Hole) Oil
Date well completed 2-16 1961
Application for plugging filed 9-22 1965
Application for plugging approved 9-27 1965
Plugging commenced 9-28 1965
Plugging completed 9-28 1965
Reason for abandonment of well or producing formation Non- economical
If a producing well is abandoned, date of last production 2-7 1965
Was permission obtained from the Conservation Division or its agents before plugging was commenced? yes

Name of Conservation Agent who supervised plugging of this well Hugh E. Scott Sublette, Kansas
Producing formation Chester Depth to top 6038 Bottom 6048 Total Depth of Well 6400 Feet
Show depth and thickness of all water, oil and gas formations.

OIL, GAS OR WATER RECORDS

CASING RECORD

FORMATION	CONTENT	FROM	TO	SIZE	PUT IN	PULLED OUT
Chester		6038	48	8-5/8	1600	None
				4-1/2	6120	2623'
				2-3/8	6064	6064'

Describe in detail the manner in which the well was plugged, indicating where the mud fluid was placed and the method or methods used in introducing it into the hole. If cement or other plugs were used, state the character of same and depth placed, from _____ feet to _____ feet for each plug set.

Mixed 20 sxs cement & pumped plug to 5800' with mud.
Spotted 35 sxs cement from 700' to 600'.
Spotted 15 sxs from 45' to surface.
Complete at 5:00 pm. 9-28-65.

RECEIVED
STATE CORPORATION COMMISSION
OCT 5 1965
CONSERVATION DIVISION
Wichita, Kansas

(If additional description is necessary, use BACK of this sheet)

Name of Plugging Contractor Sargent's Casing Pulling Service
Address 1546 Clay Courts Liberal, Kansas

STATE OF Kansas, COUNTY OF Seward, ss.
V. K. Downey (employee of owner) or (owner or operator) of the above-described

well, being first duly sworn on oath, says: That I have knowledge of the facts, statements, and matters herein contained and the log of the above-described well as filed and that the same are true and correct. So help me God.

(Signature) V. K. Downey
V. K. Downey, Div. Supt. Drlg. & Prod.
Box 351 Liberal, Kansas (Address)

SUBSCRIBED AND SWORN TO before me this 6th day of October, 1965

Donald L. Vaughsen
Notary Public.

My commission expires _____

My Commission Expires Sept. 29, 1968

Donald L. Vaughsen


WELL LOG BUREAU—KANSAS GEOLOGICAL SOCIETY
508 East Murdock, Wichita, Kansas

Company: ANADARKO PROD. CO.
Farm: Browne "A" No. 1

SEC. 9 T. 33 R.33W
C NW SE

Total Depth. 6400'
Comm. 1-12-61 Comp. 2-16-61
Shot or Treated.
Contractor. Midwestern Drillers
Issued. 7-1-61

County Seward
KANSAS

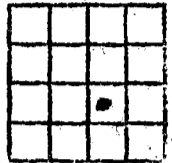

Elevation. 2823.18' GL

CASING:
8 5/8" 1600' cem w/650 sx.
4 1/2" 6120' cem w/350 sx.
2 3/8" 6064'

Production. 81 BOPD

Figures indicate Bottom of Formations.

surface sand & clay	40
surface clay, sand & gypsum	480
red bed	520
red bed & gypsum	1065
sand	1215
red bed & gypsum	1550
gypsum & Anhydrite	1600
Anhydrite	1720
shale	2000
Anhydrite & shale	2500
Anhydrite, lime & shale	2710
lime & shale	4765
lime	4805
lime & shale	6310
lime	6400
Total Depth	
TOPS: SCOUT	
Herington	2551
Council Grove	2916
Toronto	4206
Lansing	4332
Marmaton	4996
Morrow	5556
Morrow Sand	5724
Chester	5822
Chester Sand	6002
St. Genevieve	6102
St. Louis	6104

OIL OR GAS SANDS OR ZONES - PERFORATIONS - ACIDIZING & FRACTURING INFORMATION

Name	From	To	No of Shots	Gallons Used	Kind Used
Chester	6038	48	40	500	Mud Acid
				5000	15%

RECEIVED
STATE CORPORATION COMMISSION

FEB 22 1966

CONSERVATION DIVISION
Wichita, Kansas

DRILLER'S LOG

WELL NAME: Browne "A" No. 1; COMPANY OPERATING: Anadarko Production Company
 ADDRESS of COMPANY: Box 351 Liberal, Kansas

WELL LOCATION: 1/4 NW 1/4 SE 1/4,
660 ft. ~~North of North line~~ South of the North line
660 ft. East of West line; Sec. 9, Twp. 33S, Rge. 33W, Seward County, Kansas
 of SE/4

DRILLING STARTED January 12, 1961; DRILLING COMPLETED TD February 6, 1961
 WELL COMPLETED February 16, 1961; WELL CONNECTED _____, 19____

ELEVATION: 2823.18 ft. Ground Level; CHARACTER OF WELL (Oil, Gas, or Dry Hole) Oil

OIL OR GAS SANDS OR ZONES - PERFORATIONS - ACIDIZING AND FRACTURING INFORMATION					
Name	From	To	No. of Shots	Gallons Used	Kind Used
Chester	6038	48	40	500	Mud Acid
				5000	15%

RECEIVED
 STATE INFORMATION COMMISSION
 NOV 8 1965
 CONSERVATION DIVISION
 Topeka, Kansas

CASING RECORD

Size	Amount Set	Sacks of Cement	Amount Pulled
8-5/8"	1600'	650	None
4-1/2"	6120'	350	None
2-3/8"	6064'		

FORMATION RECORD

Formation	Top	Bottom	Formation	Top	Bottom
Surface Sand & Clay	0	40	Anhydrite & Shale	2000	2500
Surface Clay, Sand & Gypsum	40	480	Anhydrite, Lime & Shale	2500	2710
Red Bed	480	520	Lime & Shale	2710	4765
Red Bed & Gypsum	520	1065	Lime	4765	4805
Sand	1065	1215	Lime & Shale	4805	6270
Red Bed & Gypsum	1215	1550	Lime & Shale	6270	6310
Gypsum & Anhydrite	1550	1600	Lime	6310	6320
Anhydrite	1600	1720	Lime	6320	6400
Shale	1720	2000	Total Depth	6400	

RESULTS of INITIAL PRODUCTION TEST: February 15, 1961 - Swabbed 180 barrels of oil in
18 hours.