


STATE OF KANSAS
CORPORATION COMMISSION

WELL PLUGGING RECORD

Information Completely
Required Affidavit
Mail or Deliver Report to:
Conservation Division
State Corporation Commission
800 Bittling Building
Wichita, Kansas

NORTH

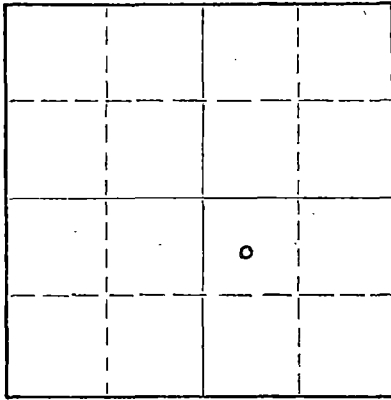

Locate well correctly on above
Section Plat

Seward County, Sec. 10 Twp. 33S Rge. 33 (W)
Location as "NE/CNW/SW" or footage from lines C NW SE
Lease Owner Falcon Seaboard Drilling Company
Lease Name Arnold Well No. 1
Office Address Pan American Building, Tulsa, Oklahoma
Character of Well (completed as Oil, Gas or Dry Hole) Dry Hole
Date well completed April 23, 19 61
Application for plugging filed April 22, 19 61
Application for plugging approved April 22, 19 61
Plugging commenced April 23, 19 61
Plugging completed April 23, 19 61
Reason for abandonment of well or producing formation _____

If a producing well is abandoned, date of last production _____ 19____
Was permission obtained from the Conservation Division or its agents before plugging was commenced? Yes

Name of Conservation Agent who supervised plugging of this well W. L. Lac Kamp, Jr.
Producing formation _____ Depth to top _____ Bottom _____ Total Depth of Well 6450 Feet
Show depth and thickness of all water, oil and gas formations.

OIL, GAS OR WATER RECORDS

CASING RECORD

FORMATION	CONTENT	FROM	TO	SIZE	PUT IN	PULLED OUT
				8-5/8	1721	None

Describe in detail the manner in which the well was plugged, indicating where the mud fluid was placed and the method or methods used in introducing it into the hole. If cement or other plugs were used, state the character of same and depth placed, from _____ feet to _____ feet for each plug set.

Set 170 sacks cement 2900' to 2400'
Set 20 sacks cement @ 650'
Set 10 sacks cement 35' to top and
Welded steel cap on top 8-5/8" casing

RECEIVED
STATE CORPORATION COMMISSION
MAY 25 1961
CONSERVATION DIVISION
WICHITA, KANSAS

(If additional description is necessary, use BACK of this sheet)
Name of Plugging Contractor Herndon Drilling Company
Address Tulsa, Oklahoma

STATE OF OKLAHOMA, COUNTY OF TULSA, ss.
J. O. Brown (employee of owner) or (owner or operator) of the above-described well, being first duly sworn on oath, says: That I have knowledge of the facts, statements, and matters herein contained and the log of the above-described well as filed and that the same are true and correct. So help me God.

(Signature) J. O. Brown
805 Pan American Building, Tulsa, Oklahoma
(Address)

SUBSCRIBED AND SWORN TO before me this 24th day of May, 1961
Kathryne Donohoo
Notary Public.

My commission expires April 6, 1963



WELL LOG

Well: **ARNOLD #1**
 Location: **C NW SE, Sec. 10-33S-33W**
Seward County, Kansas
 Owner: **Falcon Seaboard Drilling Company**

Spudding date: **3-26-61**
 Date casing set: **3-29-61**
 Date rotary completed: **4-23-61**
 Date cable completed:

FROM	TO	FORMATION	REMARKS
0	1721	Surface Hole	Ran 56 joints new 8-5/8" 24# seamless casing. Set @ 1721'.
1721	1880	Shale	
1880	2415	Shale & Shells	Cemented w/750 cu. ft. pozmix w/4% gel.
2415	2870	Lime & Shale	125 pozmix w/2% CC/1/4# flowseal per cu. ft.
2870	3080	Lime	
3080	3200	Shale & Lime	
3200	3320	Chalk & Lime	
3320	3360	Lime	
3360	3465	Lime & Shale	
3465	3970	Lime	
3970	4440	Lime & Shale	
4440	5474	Lime	
5474	5597	Lime & Shale	
5597	5665	Sand	
5665	5820	Lime & Shale	
5820	6160	Lime	
6160	6167	Shale & Lime	
6167	6450	Lime	
	6450	Total Depth	Laying down drill pipe. Cementing w/170 sx. @ 2900' to 2400' Laying down drill pipe to 650' Cementing w/20 sx. Laying down drill pipe--cementing w/10 sx. @ 35'.

RECEIVED
 STATE CORPORATION COMMISSION
 MAY 25 1961
 CONSERVATION DIVISION
 Wichita, Kansas

Subscribed and sworn to before me this 8th
 day of May, 19 61

I certify the above and foregoing to be a true and exact copy
 of the original driller's log on the ARNOLD NO. 1

Johnnie Alene Trase
 Notary Public
 My commission expires:
June 19, 1961

HERNDON DRILLING COMPANY
 By: *Patsy M. Nearing*
 Title: **Patsy M. Nearing, Asst. Secty.**