


WELL PLUGGING RECORD

Give All Information Completely  
Make Required Affidavit  
Mail or Deliver Report to:  
Conservation Division  
State Corporation Commission  
211 No. Broadway  
Wichita, Kansas

NORTH

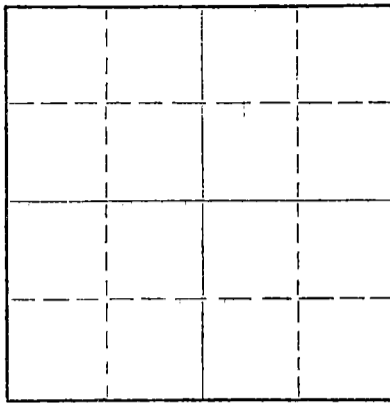

Locate well correctly on above  
Section Flat

SEWARD County, Sec. 10 Twp. 33 Rge. 33 (E) X(W)

Location as "NE/CNWxSWx" or footage from lines C/NW/NW of Sec. 10

Lease Owner The Bovaird Supply Co., U.E.Y.

Lease Name Arnold Well No. A-#1

Office Address Box 897 GREAT BEND, KANSAS

Character of Well (completed as Oil, Gas or Dry Hole) OIL

Date well completed 19

Application for plugging filed 19

Application for plugging approved 19

Plugging commenced 8-2- 19 65

Plugging completed 8-20- 19 65

Reason for abandonment of well or producing formation DRY

If a producing well is abandoned, date of last production 19

Was permission obtained from the Conservation Division or its agents before plugging was commenced?

Name of Conservation Agent who supervised plugging of this well

Producing formation Depth to top Bottom Total Depth of Well Feet

Show depth and thickness of all water, oil and gas formations.

OIL, GAS OR WATER RECORDS

CASING RECORD

FORMATION	CONTENT	FROM	TO	SIZE	PUT IN	PULLED OUT
		0	1700	8-5/8"		Left In
		0	6025	4-1/2"		2511-28

Describe in detail the manner in which the well was plugged, indicating where the mud fluid was placed and the method or methods used in introducing it into the hole. If cement or other plugs were used, state the character of same and depth placed, from feet to feet for each plug set.

Pumped one sack hulls & 20 sacks cement down 4 1/2 Oil string to Plug off bottom plug @ 5190

Circulated 30 sacks gell mud at 1700 pumped 35 sacks cement to 600 ft. Pumped 15 sacks cement from 45 ft. to top of surface.

MAR 7 1966

(COPY)

(If additional description is necessary, use BACK of this sheet)

Name of Plugging Contractor Apex casing Pulling Co.

Address 739 East 2nd, Hoiington, Kansas

STATE OF Kansas, COUNTY OF Barton, ss.  
Owner

(employee of owner) or (owner or operator) of the above-described well, being first duly sworn on oath, says: That I have knowledge of the facts, statements, and matters herein contained and the log of the above-described well as filed and that the same are true and correct. So help me God.

(Signature) Joseph D. Anthony

(Address)

SUBSCRIBED AND SWORN TO before me this 3rd day of March, 19 66

My commission expires Jan. 26, 1967

Carmen R. Cook, Notary Public.