

15-175-00140-0000

STATE OF KANSAS
STATE CORPORATION COMMISSION

Form CP-4

Give All Information Completely
Make Required Affidavit
Mail or Deliver Report to:
Conservation Division
State Corporation Commission
212 No. Market
Wichita, Kansas 67202

WELL PLUGGING RECORD

Seward County, Sec. 14 Twp. 33S Rge. 33W ~~33E~~ (W)X

Location as "NE/CNW%SW%" or footage from lines 100' N & 100' W of C

Lease Owner Cities Service Oil Company

Lease Name Hunt "B" Well No. 1

Office Address Box 1098, Liberal, Kansas

Character of Well (completed as Oil, Gas or Dry Hole) Gas

Date well completed 7-28 1950

Application for plugging filed 2-22 1972

Application for plugging approved 2-24 1972


Plugging commenced 3-20 1972

Plugging completed 3-21 1972

Reason for abandonment of well or producing formation Depleted

If a producing well is abandoned, date of last production 8-1 1971

Was permission obtained from the Conservation Division or its agents before plugging was commenced? Yes

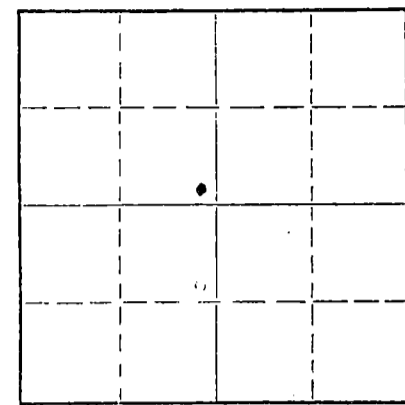

Locate well correctly on above Section Plat

Name of Conservation Agent who supervised plugging of this well E. Eves

Producing formation Krider & Herrington Depth to top 2574 Bottom 2656' Total Depth of Well 2745' Feet

Show depth and thickness of all water, oil and gas formations.

OIL, GAS OR WATER RECORDS

CASING RECORD

FORMATION	CONTENT	FROM	TO	SIZE	PUT IN	PULLED OUT
Herrington	Gas	2574'	2584'	5-1/2"	2745'	0
Krider	Gas	2606'	2656'			

Describe in detail the manner in which the well was plugged, indicating where the mud fluid was placed and the method or methods used in introducing it into the hole. If cement or other plugs were used, state the character of same and depth placed, from _____ feet to _____ feet for each plug set.

2534' - 2656' 35 sx cement
 958' - 2534' Mud
 853' - 958' 15 sx cement
 35' - 853' Mud
 0' - 35' 5 sx cement

RECEIVED
STATE CORPORATION COMMISSION
MAR 27 1972
CONSERVATION DIVISION
Wichita, Kansas

(If additional description is necessary, use BACK of this sheet)

Name of Plugging Contractor Sargent's Casing & Pulling Service

Address Liberal, Kansas

STATE OF KANSAS, COUNTY OF SEWARD, ss.

C. A. Nenny (employee of owner) or (owner or operator) of the above-described well, being first duly sworn on oath, says: That I have knowledge of the facts, statements, and matters herein contained and the log of the above-described well as filed and that the same are true and correct. So help me God.

(Signature) C. A. Nenny

Box 1098, Liberal, Kansas (Address)

SUBSCRIBED AND SWORN to before me this 22nd day of March, 19 72

B. J. McGriff
Notary Public.

My commission expires 8-6-74

ROTARY DRILLING LOG

LEASE:	Hunt "B" #1	CASING:	8-5/8" @ 880/375
OWNER:	Cities Service Oil Company	COMMENCE:	6-7-50
CONTRACTOR:	Barbour Drilling Co.	COMPLETE:	7-28-50
LOCATION:	100' N & 100' W of Center Sec. 14-33S-33W, Seward Co., Kans.		

Sand and Clay	0' - 300'
Shale	300' - 400'
Sand and Shale	400' - 795'
Sand & Shale	795' - 845'
Red Bed and Blue Shale	845' - 860'
Sand	860' - 1465'
Anhydrite & Gyp	1465' - 1645'
Sand & Shale	1645' - 1870'
Shale & Lime	1870' - 2130'
Shale & Anhydrite	2130' - 2225'
Shale & Lime	2225' - 2440'
Lime & Anhydrite	2440' - 2520'
Lime	2520' - 2620'
Lime & Shale	2620' - 2745'
Rotary Total Depth	2745'

RECEIVED
STATE CORPORATION COMMISSION
FEB 24 1972
CONSERVATION DIVISION
Wichita, Kansas

We certify that the above log is true and correct to the best of our knowledge and belief.

CITIES SERVICE OIL COMPANY

By R. L. Higginbottom
R. L. Higginbottom
District Manager