

STATE OF KANSAS  
STATE CORPORATION COMMISSION

Give All Information Completely  
Make Required Affidavit  
Mail or Deliver Report to:  
Conservation Division  
State Corporation Commission  
211 No. Broadway  
Wichita, Kansas

WELL PLUGGING RECORD

Seward County, Sec. 14 Twp. 33S Rge. (E) 33 (W)

Location as "NE/CNW/SW" or footage from lines 1980' from W 1930' from S

Lease Owner Cities Service Petroleum Co.

Lease Name Hunt "F" Well No. 1

Office Address Box 1147 Liberal, Kansas

Character of Well (completed as Oil, Gas or Dry Hole) Dry hole

Date well completed 5-16-61 19 61

Application for plugging filed 5-19-61 19 61

Application for plugging approved 5-25- 19 61


Plugging commenced 6-23- 19 61

Plugging completed 6-24- 19 61

Reason for abandonment of well or producing formation Dry hole

If a producing well is abandoned, date of last production 19

Was permission obtained from the Conservation Division or its agents before plugging was commenced? Yes

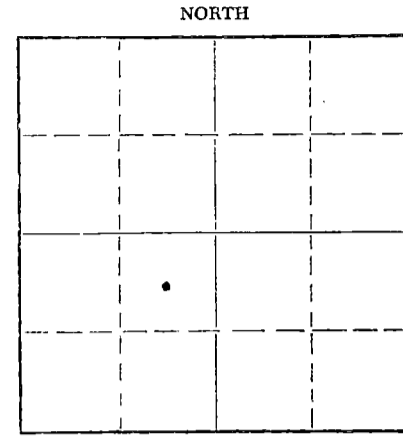

Locate well correctly on above Section Plat

Name of Conservation Agent who supervised plugging of this well Mr. Frank Broadfoot

Producing formation Dry hole Depth to top Bottom Total Depth of Well Feet

Show depth and thickness of all water, oil and gas formations.

OIL, GAS OR WATER RECORDS

CASING RECORD

FORMATION	CONTENT	FROM	TO	SIZE	PUT IN	PULLED OUT
Chester	Dry	5832	5841	8 5/8"	1599'	None
Morrow	Dry	5793	5819	4 1/2"	5900'	2002'
Morrow	Dry	5654'	5658'			
Marmaton	Dry	5083'	5087'			
Lansing	Dry	4680'	4682'			

Describe in detail the manner in which the well was plugged, indicating where the mud fluid was placed and the method or methods used in introducing it into the hole. If cement or other plugs were used, state the character of same and depth placed, from feet to feet for each plug set.

Mixed 50 sx common cement pumped plug to 4436' w/2000# pressure

Heavy mud 4436' to 1516'

Spotted 20 sx cement 1516' to 1456'

Heavy mud 1456' to 774'

Spotted 20 sx cement 774' to 714'

Heavy Mud 714' to 35'

Spotted 10 sx cement 35' to surface

RECEIVED  
STATE CORPORATION COMMISSION  
JUL 6 1961  
CONSERVATION DIVISION  
Wichita, Kansas

(If additional description is necessary, use BACK of this sheet)

Name of Plugging Contractor Daco Lease and Well Service

Address Borger, Texas

STATE OF Kansas, COUNTY OF Seward, ss.  
I, W. J. Devaney (employee of owner) or (owner/operator) of the above-described

well, being first duly sworn on oath, says: That I have knowledge of the facts, statements, and matters herein contained and the log of the above-described well as filed and that the same are true and correct. So help me God.

(Signature) *W. J. Devaney*

Box 1147 Liberal, Kansas (Address)

SUBSCRIBED AND SWORN TO before me this 26th day of June, 1961

My commission expires 3-31-65

*James F. Kyger*  
James F. Kyger Notary Public



Copy


WELL LOG BUREAU—KANSAS GEOLOGICAL SOCIETY  
508 East Murdock, Wichita, Kansas

Company- CITIES SERVICE PETROLEUM  
Farm. Hunt "F" No. 1

SEC. 14 T. 33 R. 33W  
C NE SW

Total Depth. 6504'  
Comm. 3-23-61 Comp. 4-13-61  
Shot or Treated.  
Contractor. R. W. Rine Drlg.  
Issued: 8-5-61

County Seward  
KANSAS

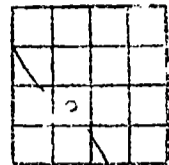

Elevation. 2824' RB

Production. Dry

CASING:

3 5/8" 1600' cem w/600 sx.  
4 1/2" 5900' cem w/175 sx.

Figures indicate Bottom of Formations.

surface sand, clay	40
sand, gyp	550
red bed	680
red bed, gyp	965
sand	1165
sand	1225
gyp (Anhy ?)	1444
shale, salt, anhydrite	1600
Anhydrite	1625
red bed, shale, anhydrite	2080
anhydrite, shale	2365
lime, shale	2580
lime, shale, sand	2830
lime	2971
lime, shale strks	3060
lime, shale	3206
lime	3380
lime chalky	3535
lime, chalk	3639
lime	3905
lime, w/shale strks	4225
lime, shale	4300
lime	4350
lime w/chert	4429
lime	4775
lime, shale	4843
lime	5015
lime, sand	5102
lime	5154
lime, chert	5236
lime	5411
lime, shale	5709
lime, shale, sand	5814
lime, shale	5870
lime, sand	5978
lime, shale	6049
lime	6319
hrd sdy lime	6350
hrd lime, chert	6398
lime, chert	6417
lime, chert	6504
Total Depth	

TOPS: SCOUT

Council Grove	2965
Heebner	4248
Toronto	4266
Lansing	4384
Marmaton	5058
Morrow	5608
Morrow Sand	5651
Morrow Sand	5781
Chester	5828
Chester Sdy Lime	6041
St. Genevieve	6182
St. Louis	6356