

STATE OF KANSAS
STATE CORPORATION COMMISSION

Form CP-4

Give All Information Completely
Make Required Affidavit
Mail or Deliver Report to:
Conservation Division
State Corporation Commission
212 No. Market
Wichita, Kansas 67202

WELL PLUGGING RECORD

C NW NW County. Sec. 14 Twp. 33S Rge. 33W (XX) (W)

Location as "NE/CNW&SW&" or footage from lines 330

Lease Owner ~~XXXX~~ National Oil Co.

Lease Name Hunt Well No. 1

Office Address 200 W. Douglas-Suite 550, Wichita, Ks

Character of Well (completed as Oil, Gas or Dry Hole) D&A

Date well completed 1/12/72 19

Application for plugging filed 1/12/72 19

Application for plugging approved 1/12/72 19


Plugging commenced 1/12/72 19

Plugging completed 1/12/72 19

Reason for abandonment of well or producing formation no commercial shows of oil or gas encountered

If a producing well is abandoned, date of last production 19

Was permission obtained from the Conservation Division or its agents before plugging was commenced? yes

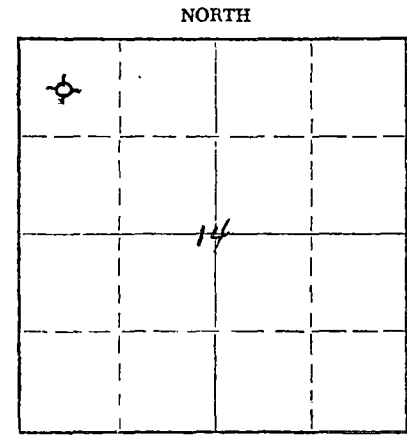

Locate well correctly on above Section Plat

Name of Conservation Agent who supervised plugging of this well Edgar J. Eves

Producing formation _____ Depth to top _____ Bottom _____ Total Depth of Well _____ Feet

Show depth and thickness of all water, oil and gas formations.

OIL, GAS OR WATER RECORDS

CASING RECORD

FORMATION	CONTENT	FROM	TO	SIZE	PUT IN	PULLED OUT
Surf hole	8 5/8"	surf	1542	8 5/8"	1542'	none

Describe in detail the manner in which the well was plugged, indicating where the mud fluid was placed and the method or methods used in introducing it into the hole. If cement or other plugs were used, state the character of same and depth placed, from _____ feet to _____ feet for each plug set.

Plug @1100' w/35 sx

Plug @ 45' w/15 sx

RECEIVED
STATE CORPORATION COMMISSION
FEB 18 1972
CONSERVATION DIVISION
Wichita, Kansas

(If additional description is necessary, use BACK of this sheet)

Name of Plugging Contractor Lohmann-Johnson Drilling Co.
Address 1701 Fidelity Natl. Bldg. - Oklahoma City, Okla.

STATE OF Kansas, COUNTY OF Sedgwick, ss.
Larry L. Taylor (employee of owner) or (owner or operator) of the above-described

well, being first duly sworn on oath, says: That I have knowledge of the facts, statements, and matters herein contained and the log of the above-described well as filed and that the same are true and correct. So help me God.

(Signature) Larry L. Taylor

200 W. Douglas - Suite 550, Wichita, Ks.

(Address)

Subscribed and Sworn to before me this 17th day of February, 1972



Jean Stocks

Jean Stocks

Notary Public.



STATE OF KANSAS
 DEPARTMENT OF MINES AND MINERALS
 OIL AND GAS DIVISION

XXXXXXXXXX
 XXXXXXXXXXXX

Permit No. _____ Oil or Gas Well Dry Hole
(Rhd)

Company NATIONAL OIL COMPANY
 Address 200 W. Douglas, Ste 550, Wichita, Kansas
 Farm HUNT Acres _____
 Location (waters) NW NW - Section 14-33S-33W
 Well No. 1 Elev. _____
 District _____ County Seward
 Drilling Commenced 12-22-71
 Drilling Completed 1-12-72
 Name of Contractor LOHMANN-JOHNSON DRILLING CO., INC
 Address of Contractor 1302 OLD NATIONAL BANK BLDG., EVANSVILLE, INDIANA
 Date Shot _____ From _____ To _____
 With _____
 Open flow /10ths Water in _____ Inch
 /10ths Merc. in _____ Inch

Casing and Used in Left In Tubing Drilling Well
 Size _____ Kind of Packer _____
 16 _____
 13 _____
 10 _____ Size of _____
 8 1/4 8-5/8" set @ 1542' w/550 Sks. Cement
 6 1/2 _____ Depth Set _____
 5 3/16 _____
 3 _____ Perf. top _____
 2 _____ Perf. bottom _____
 _____ Perf. top _____
 _____ Perf. bottom _____
 Casing Cemented _____ Size _____ No. Ft. _____ Date _____

Formation	Color	Hard or Soft	Top	Bottom	Oil, Gas & Coal or Water	Depth Found	Remarks
SURFACE			0	426			
WATER SAND & RED BED			426	851			
RED BED & GYP			851	1070			
SAND			1070	1225			
RED BED & GYP			1225	1540			
RED BED & ANHYD.			1540	1550			
RED BED			1550	2090			
RED BED & ANHYD.			2090	2300			
LIME & SHALE			2300	3873			
LIME			3873	3950			
LIME & SHALE			3950	4638			
LIME, SAND & SHALE			4638	4740			
LIME & SHALE			4740	4960			
LIME			4960	4993			
LIME & SHALE			4993	5235			
LIME			5235	5390			
LIME & SHALE			5390	5600			
LIME, SHALE & SAND			5600	5746			
LIME & SHALE			5746	5756			
LIME, SHALE & SAND			5756	5795			
LIME & SHALE			5795	5880			
LIME			5880	5980			
LIME & SHALE			5980	6442			
6441			TOTAL DEPTH				

RECEIVED
 STATE CORPORATION COMMISSION
 MAR 7 1972
 CONSERVATION DIVISION
 Wichita, Kansas

DRY & ABANDONED -- Plugged

We, the undersigned, hereby certify that the above is a true and correct Log of the formations encountered in drilling this Well in accordance with the Daily Drilling Reports.
 LOHMANN-JOHNSON DRILLING CO., INC.

By: Curtis A. Scheible
 Curtis A. Scheible, Vice-President

Subscribed and sworn to before me
 this 24th Day of February, 1972
Weldon V. Freed
 Notary Public
 My Commission expires:
 November 5, 1973