


WELL PLUGGING RECORD

Give All Information Completely
Make Required Affidavit
Mail or Deliver Report to:
Conservation Division
State Corporation Commission
211 No. Broadway
Wichita, Kansas

NORTH

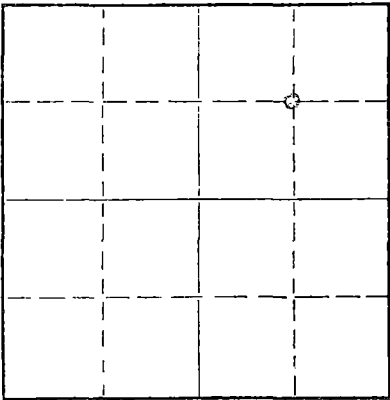

Locate well correctly on above
Section Plat

Seward County, Sec. 9 Twp. 33S Rge. (E) 31 (W)

Location as "NE/CNW/SW" or footage from lines NE/4

Lease Owner Whitestone Petroleum Corporation

Lease Name B. L. SWAFFORD Well No. 1

Office Address 900 Vaughn Bldg., Dallas 1, Texas

Character of Well (completed as Oil, Gas or Dry Hole) Dry Hole

Date well completed _____ 19__

Application for plugging filed December 25 1962

Application for plugging approved December 25 1962

Plugging commenced December 25 1962

Plugging completed December 25 1962

Reason for abandonment of well or producing formation No commercial zones

If a producing well is abandoned, date of last production - - 19- -

Was permission obtained from the Conservation Division or its agents before plugging was commenced? Yes

Name of Conservation Agent who supervised plugging of this well Mr. Hugh Scott

Producing formation - - Depth to top - - Bottom - - Total Depth of Well 6110 Feet

Show depth and thickness of all water, oil and gas formations.

OIL, GAS OR WATER RECORDS

CASING RECORD

FORMATION	CONTENT	FROM	TO	SIZE	PUT IN	PULLED OUT
				13-3/8"	40'	0'
				8-5/8"	2307'	0'

Describe in detail the manner in which the well was plugged, indicating where the mud fluid was placed and the method or methods used in introducing it into the hole. If cement or other plugs were used, state the character of same and depth placed, from _____ feet to _____ feet for each plug set.

Pumped cement down drill pipe and one 35-sack plug was placed from 700' to 600', and a second plug of 15 sacks was placed from 40' to the surface of the ground. The remainder of the hole was filled with 9.2#/gallon drilling mud.

RECEIVED
STATE CORPORATION COMMISSION
JAN 2 1963
CONSERVATION DIVISION
Wichita, Kansas

(If additional description is necessary, use BACK of this sheet)

Name of Plugging Contractor Halliburton Company

Address Duncan, Oklahoma

STATE OF TEXAS, COUNTY OF DALLAS, ss.

Dale O. Chase (employee of owner) or (owner or operator) of the above-described

well, being first duly sworn on oath, says: That I have knowledge of the facts, statements, and matters herein contained and the log of the above-described well as filed and that the same are true and correct. So help me God.

(Signature) Dale O. Chase

900 Vaughn Bldg., Dallas 1, Texas

(Address)

SUBSCRIBED AND SWORN to before me this 28th day of December, 1962

My commission expires June 1, 1963

Emmalee Rood
Notary Public.

