


STATE OF KANSAS
STATE CORPORATION COMMISSION

WELL PLUGGING RECORD

Give All Information Completely
Make Required Affidavit
Mail or Deliver Report to:
Conservation Division
State Corporation Commission
212 North Market, Insurance Bldg.
Wichita, Kansas

SEWARD County. Sec. 11 Twp. 33S Rge. 31 (E) (W)
Location as "NE/CNW/SW" or footage from lines 1,980' FR SOUTH; 660' FR WEST
Lease Owner THE SHAMROCK OIL & GAS CORPORATION
Lease Name RAY RINEHART Well No. 1
Office Address BOX 631 AMARILLO, TEXAS
Character of Well (completed as Oil, Gas or Dry Hole) DRY HOLE
Date well completed 10-10 1959
Application for plugging filed 10-10 1959
Application for plugging approved 10-10 1959
Plugging commenced 10-10 1959
Plugging completed 10-11 1959
Reason for abandonment of well or producing formation DRY

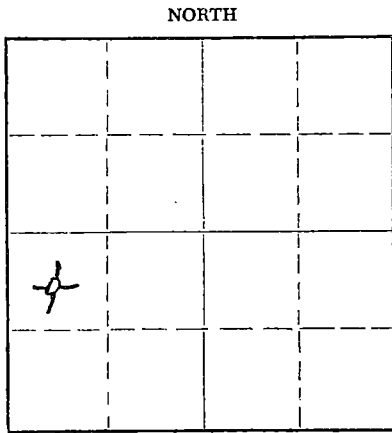

Locate well correctly on above
Section Plat

If a producing well is abandoned, date of last production 19
Was permission obtained from the Conservation Division or its agents before plugging was commenced? YES

Name of Conservation Agent who supervised plugging of this well FRANK BROADFOOT /OF/ ST. JOHNS, KANSAS
Producing formation _____ Depth to top _____ Bottom _____ Total Depth of Well 5715 Feet
Show depth and thickness of all water, oil and gas formations.

OIL, GAS OR WATER RECORDS

CASING RECORD

FORMATION	CONTENT	FROM	TO	SIZE	PUT IN	PULLED OUT
SAND & SHALE	POS. WTR.	0	510	9 5/8"	1,591.86	-0-

Describe in detail the manner in which the well was plugged, indicating where the mud fluid was placed and the method or methods used in introducing it into the hole. If cement or other plugs were used, state the character of same and depth placed, from _____ feet to _____ feet for each plug set.
FILLED HOLE TO 600' WITH MUD. PUSHED 9 5/8" PLUG TO 600'. SPOTTED 35 SACKS CEMENT AT 600'. FILLED HOLE TO 40' WITH MUD. PUSHED 9 5/8" PLUG TO 40'. FILLED HOLE TO SURFACE WITH 25 SACKS CEMENT.

RECEIVED
STATE CORPORATION COMMISSION
OCT 16 1959
CONSERVATION DIVISION
Wichita, Kansas

(If additional description is necessary, use BACK of this sheet)
Name of Plugging Contractor HALLIBURTON OIL WELL CEMENTING COMPANY
Address LIBERAL, KANSAS

STATE OF TEXAS, COUNTY OF POTTER, ss.
T. S. Clopton (employee of owner) or (~~owner or operator~~) of the above-described well, being first duly sworn on oath, says: That I have knowledge of the facts, statements, and matters herein contained and the log of the above-described well as filed and that the same are true and correct. So help me God.

(Signature) T. S. Clopton
Box 631, Amarillo, Texas (Address)

SUBSCRIBED AND SWORN TO before me this 15th day of October, 1959
My commission expires 6-1-61
Pauline Powell Notary Public
Potter County, Texas

RAY RINEHART NO. 1

SECTION 11, TOWNSHIP 33 S. RANGE 31 WEST

SEWARD COUNTY, KANSAS

ELEVATION-2,758' DF

0	-	510	SAND AND SHALE
510	-	820	RED BED AND SHALE
820	-	1,245	SHALE, GYP AND SHELLS
1,245	-	1,535	SHALE AND SHELLS
1,535	-	1,955	SHALE, SHELLS, ANHYDRITE
1,955	-	2,150	SHALE, AND SHELLS
2,150	-	2,607	LIME AND SHALE
2,607	-	2,657	LIME
2,657	-	2,833	LIME AND SHALE
2,833	-	2,930	LIME
2,930	-	4,061	LIME AND SHALE
4,061	-	4,123	CHALK, LIME AND SHALE
4,123	-	4,467	LIME AND SHALE
4,467	-	4,610	LIME
4,610	-	4,661	LIME, CHERT, SHALE
4,661	-	5,441	LIME
5,441	-	5,715	LIME AND SHALE