


WELL PLUGGING RECORD

Give All Information Completely
Make Required Affidavit
Mail or Deliver Report to:
Conservation Division
State Corporation Commission
211 No. Broadway
Wichita, Kansas

Seward County, Sec. 14 Twp. 33S Rge. 31W (X) (W)

Location as "NE/CNWxSWx" or footage from lines 50' W/C SW SW
Lease Owner Socony Mobil Oil Company, Inc.
Lease Name Elizabeth Shelden Well No. 1
Office Address 300 N. Broadway, Wichita, Kansas 67202
Character of Well (completed as Oil, Gas or Dry Hole) Drilled Dry
Date well completed 5-25-65 (D&A) 19
Application for plugging filed 5-26-65 19
Application for plugging approved 5-24-65 19
Plugging commenced 5-24-65 19
Plugging completed 5-24-65 19
Reason for abandonment of well or producing formation Drilled Dry

NORTH

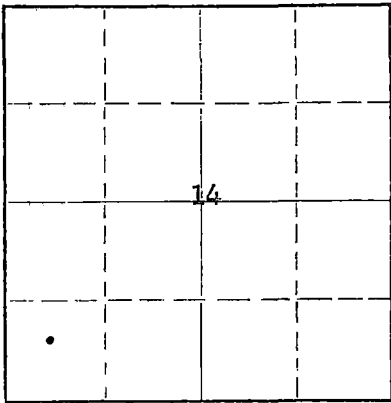

Locate well correctly on above Section Plat

If a producing well is abandoned, date of last production 19
Was permission obtained from the Conservation Division or its agents before plugging was commenced? Yes

Name of Conservation Agent who supervised plugging of this well Hugh Scott
Producing formation - Depth to top Bottom Total Depth of Well 6063 Feet
Show depth and thickness of all water, oil and gas formations.

OIL, GAS OR WATER RECORDS

CASING RECORD

FORMATION	CONTENT	FROM	TO	SIZE	PUT IN	PULLED OUT
				8 5/8"	1569	None

Describe in detail the manner in which the well was plugged, indicating where the mud fluid was placed and the method or methods used in introducing it into the hole. If cement or other plugs were used, state the character of same and depth placed, from feet to feet for each plug set.

Set 35 sacks cement plug @ 1700'. Set an 8 5/8" Wood plug with 15 sacks cement from 45' to ground level.

RECEIVED
STATE CORPORATION COMMISSION

JUN 1 1965

CONSERVATION DIVISION
Wichita, Kansas

(If additional description is necessary, use BACK of this sheet)
Name of Plugging Contractor Lohmann-Johnson Drilling Company
Address 320 Indiana Bank Bldg., Evansville, Indiana

STATE OF Kansas, COUNTY OF Sedgwick, ss.
T. V. Herriage (employee of owner) of the above-described well, being first duly sworn on oath, says: That I have knowledge of the facts, statements, and matters herein contained and the log of the above-described well as filed and that the same are true and correct. So help me God.

(Signature) P. A. Griffin Dist. Acctg. Group Supr.
300 N. Broadway, Wichita, Kansas 67202
(Address)

SUBSCRIBED AND SWORN TO before me this 27th day of May, 1965

My commission expires 4-4-66

Jack Searden Notary Public.



STATE OF KANSAS

Permit No.

Oil or Gas Well Dry Hole
(Kind)

Company Mobil Oil Company Casing and Used in Left In Tubing
Address 300 North Broadway, Wichita, Kansas Drilling Well
Farm Elizabeth Shelden Acres.....
SW SW Section 14-33S-31W Location (waters).....
Well No..... Elev.....
District..... County Seward 8-5/8" - 1570 ft. Kind of Packer
Drilling Commenced May 8, 1965 6% Depth Set.....
Drilling Completed May 24, 1965 5 3/16 Perf. top.....
Name of Contractor Lohmann-Johnson Drilling Co., Inc 3 Perf. bottom.....
Address of Contractor 320 Indiana Bank Bldg., Evansville, Indiana 2 Perf. top.....
Date Shot..... From..... To..... Perf. bottom.....
With.....
Open flow /10ths Water in..... Inch Casing Cemented..... Size..... No. Ft..... Date.....
/10ths Merc. in..... Inch

Formation	Color	Hard or Soft	Top	Bottom	Oil, Gas & Coal or Water	Depth Found	Remarks
SAND			0	628			
RED BED, SHALE & SAND			628	940			
RED BED			940	975			
SAND			975	1125			
SHALE & ANHYDRITE			1125	1570			
RED BED			1570	2130			
SHALE & LIME			2130	2396			
LIME & SHALE			2396	2588			
LIME			2588	2690			
LIME & SHALE			2690	3245			
LIME - CHALK SHALE			3245	3520			
LIME & SHALE			3520	3632			
LIME & SHALE, CHALK			3632	3863			
LIME & SHALE			3863	4381			
LIME			4381	5630			
LIME & SHALE			5630	5742			
LIME & CHERT			5742	5787			
LIME			5787	6063			
TOTAL DEPTH			6063				

RECEIVED
STATE CORPORATION COMMISSION
JUN 15 1965
CONSERVATION DIVISION
Wichita, Kansas

DRY & ABANDONED - WELL PLUGGED 5/24/65

The undersigned, LOHMANN-JOHNSON DRILLING CO., INC. hereby certifies that the above Log is a true and correct Log of the formations encountered in drilling this Well in accordance with the Daily Drilling Reports

LOHMANN-JOHNSON DRILLING CO., INC

By Joe Loehr Asst Secy

Subscribed and sworn to before me this 8th day of June, 1965

Helen V Frields
Helen V Frields - Notary Public
My Commission expires
November 5, 1965