


Give All Information Completely
Make Required Affidavit
Mail or Deliver Report to:
Conservation Division
State Corporation Commission
211 No. Broadway
Wichita, Kansas

WELL PLUGGING RECORD

Seward County, Sec. 14 Twp. 33S Rge. (E) 31 (W)
Location as "NE/CNW/SW" or footage from lines 50' W/C SWSW
Lease Owner Cleary Petroleum, Inc.
Lease Name Sheldon Well No. 1
Office Address 310 Kermac Building, Oklahoma City, Oklahoma 73102
Character of Well (completed as Oil, Gas or Dry Hole) Gas
Date well completed 12-10-65 19
Application for plugging filed 4-23-68 19
Application for plugging approved 5-6-68 19
Plugging commenced 4-26-68 19
Plugging completed 5-23-68 19
Reason for abandonment of well or producing formation Uneconomical

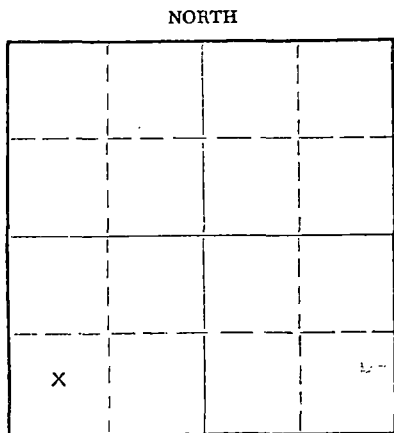

Locate well correctly on above Section Plat

If a producing well is abandoned, date of last production February 1968
Was permission obtained from the Conservation Division or its agents before plugging was commenced? Yes

Name of Conservation Agent who supervised plugging of this well E. Eves, Box 'F', Sublette, Kansas
Producing formation Morrow Depth to top 5588 Bottom 5592 Total Depth of Well 5650 Feet
Show depth and thickness of all water, oil and gas formations. PBTB

OIL, GAS OR WATER RECORDS

CASING RECORD

FORMATION	CONTENT	FROM	TO	SIZE	PUT IN	PULLED OUT
Morrow	gas	5588	92	5 1/2	6035	2200

Describe in detail the manner in which the well was plugged, indicating where the mud fluid was placed and the method or methods used in introducing it into the hole. If cement or other plugs were used, state the character of same and depth placed, from feet to feet for each plug set.

Set 25 sack cement plug at 4,878'; pumped in 35 sacks from 800 - 900'; 40 sacks from 172' to surface; Welded on metal plate.

RECEIVED
STATE CORPORATION COMMISSION
JUN 6 1968
CONSERVATION DIVISION
Wichita, Kansas

(If additional description is necessary, use BACK of this sheet)
Name of Plugging Contractor Gayle Toland
Address

STATE OF Oklahoma, COUNTY OF Oklahoma, ss.
Jack H. Landrum (employee of owner) or (owner or operator) of the above-described well, being first duly sworn on oath, says: That I have knowledge of the facts, statements, and matters herein contained and the log of the above-described well as filed and that the same are true and correct. So help me God.

(Signature) Jack H. Landrum
310 Kermac Building, Oklahoma City, Oklahoma 73102
(Address)

SUBSCRIBED AND SWORN TO before me this 3rd day of June, 1968

My commission expires October 16, 1970

Phyllis J. Jaffer
Notary Public.