


Give All Information Completely
Make Required Affidavit
Mail or Deliver Report to:
Conservation Division
State Corporation Commission
212 No. Market
Wichita, Kansas

WELL PLUGGING RECORD

NORTH

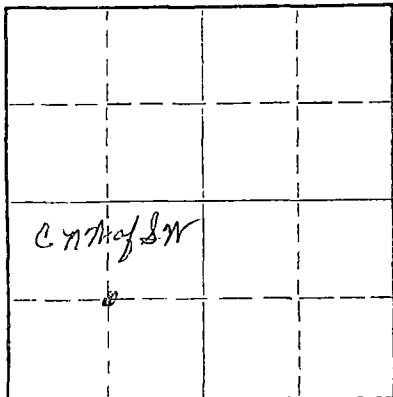

Locate well correctly on above
Section Plat

Seward County, Sec. 2 Twp. 33S Rge. 31W (E) (W)
Location as "NE/CNW*SW*" or footage from lines. C NW of SW
Lease Owner Amarillo Natural Gas Company
Lease Name Headrick Well No. 2
Office Address 305 Bank of the Southeast, Amarillo, Texas 79109
Character of Well (completed as Oil, Gas or Dry Hole) Dry Hole
Date well completed 5-10-67 19
Application for plugging filed 5-10-67 19
Application for plugging approved 5-10-67 19
Plugging commenced 5-10-67 19
Plugging completed 5-10-67 19
Reason for abandonment of well or producing formation Dry Hole

If a producing well is abandoned, date of last production None 19
Was permission obtained from the Conservation Division or its agents before plugging was commenced? Yes

Name of Conservation Agent who supervised plugging of this well
Producing formation Depth to top Bottom Total Depth of Well 6000 Feet
Show depth and thickness of all water, oil and gas formations.

OIL, GAS OR WATER RECORDS

CASING RECORD

FORMATION	CONTENT	FROM	TO	SIZE	PUT IN	PULLED OUT
Surface		0	1300	8-5/8"	1300'	None

Describe in detail the manner in which the well was plugged, indicating where the mud fluid was placed and the method or methods used in introducing it into the hole. If cement or other plugs were used, state the character of same and depth placed, from feet to feet for each plug set.
Plug @ 700' W/35 Sacks cement and Plug 45' 15 Sacks Cement

RECEIVED
STATE CORPORATION COMMISSION
MAY 12 1967
CONSERVATION DIVISION
WICHITA, KANSAS

(If additional description is necessary, use BACK of this sheet)

Name of Plugging Contractor Mahoney Drilling Co., Inc.
Address P. O. Box 1257 Liberal, Kansas 67901

STATE OF Texas, COUNTY OF Potter, ss.
L. E. Geoffroy (operator) of the above-described well, being first duly sworn on oath, says: That I have knowledge of the facts, statements, and matters herein contained and the log of the above-described well as filed and that the same are true and correct. So help me God.

(Signature) L. E. Geoffroy, Vice President
305 Bank of the Southwest
Amarillo, Texas 79109

SUBSCRIBED AND SWORN TO before me this 11 day of May, 1967
My commission expires 6/1/67
Notary Public.

RECEIVED
STATE CORPORATION COMMISSION

MAY 18 1967

DRILLING LOG

CONSERVATION DIVISION
Wichita, Kansas

LEASE OWNER Amarillo Natural Gas Co. ADDRESS Amarillo, Texas
LEASE Headrick COUNTY Seward DESCRIPTION NW4 SW4 Sec. 2-33S-31W

CASING: SIZE 8-5/8" WEIGHT 23# AMOUNT 1300
CEMENT: AMOUNT 700 Sx. CIRCULATED: Yes X No
CASING: SIZE WEIGHT AMOUNT
CEMENT: AMOUNT Sx. CIRCULATED: Yes No
PLUG SET: 700 Ft. TO Ft. CEMENT 35 Sx.
45 Ft. TO Ft. CEMENT 15 Sx.

FORMATION AND DEPTH

Surface Sand & Shale	0	TO	525
Red Bed	525	TO	568
Red Bed & Anhydrite	568	TO	1116
Sand	1116	TO	1168
Red Bed & Gyp	1168	TO	1301
Anhydrite & Red Bed	1301	TO	2520
Shale ;& Lime	2520	TO	4428
Lime	4428	TO	5488
Lime & Shale	5488	TO	5692
Lime	5692	TO	6000
T.D	6000	TO	
		TO	
		TO	
		TO	
		TO	

THIS IS A TRUE AND EXACT COPY OF THE FORMATIONS TAKEN FROM THE DAILY DRILLING REPORTS.

Executed this 10 day of May 19 67

By J. W. Mahoney

IN WITNESS WHEREOF, I have hereunto set my hand and affixed my official seal the day and year above written.

George W. Carnahan, Jr.
Notary Public

MY COMMISSION EXPIRES: January 24, 1968