


STATE OF KANSAS
STATE CORPORATION COMMISSION

WELL PLUGGING RECORD

Give All Information Completely
Make Required Affidavit
Mail or Deliver Report to:
Conservation Division
State Corporation Commission
211 No. Broadway
Wichita, Kansas

NORTH

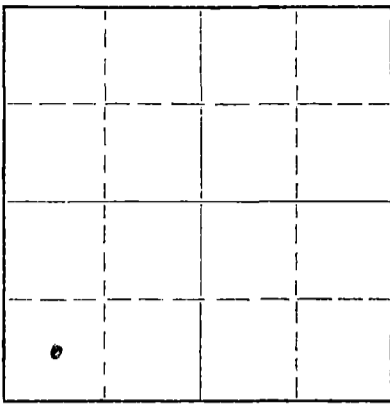

Locate well correctly on above
Section Plat

Seward County. Sec. 3 Twp. 33S Rge. 31 (E) W(W)
Location as "NE/CNW/SW" or footage from lines. SW SW
Lease Owner Edwin L. Cox
Lease Name Light "A" Well No. 1
Office Address 2100 Adolphus Tower, Dallas 2, Texas
Character of Well (completed as Oil, Gas or Dry Hole) Dry Hole
Date well completed Dry Hole August 6, 1961
Application for plugging filed Approval by phone August 3, 1961
Application for plugging approved August 3, 1961
Plugging commenced August 6, 1961
Plugging completed August 6, 1961
Reason for abandonment of well or producing formation Dry Hole

If a producing well is abandoned, date of last production NA 19
Was permission obtained from the Conservation Division or its agents before plugging was commenced? YES

Name of Conservation Agent who supervised plugging of this well Mr. Frank Broodfoot, St John Kansas
Producing formation None Depth to top - Bottom - Total Depth of Well 6010 Feet
Show depth and thickness of all water, oil and gas formations.

OIL, GAS OR WATER RECORDS

CASING RECORD

FORMATION	CONTENT	FROM	TO	SIZE	PUT IN	PULLED OUT
Council Grove	Sand & Water	3152	3177	8-5/8	1553.26	None
Tronton	San	4304	4322			
Morrow	Sly OCM	5600	5630			

Describe in detail the manner in which the well was plugged, indicating where the mud fluid was placed and the method or methods used in introducing it into the hole. If cement or other plugs were used, state the character of same and depth placed, from _____ feet to _____ feet for each plug set.

Filled hole with heavy mud to 600'. Placed 30 sacks cement from 600' to 450' and 20 sacks from top to 55'.

RECEIVED
STATE CORPORATION COMMISSION

AUG 10 1961

CONSERVATION DIVISION
Wichita, Kansas

(If additional description is necessary, use BACK of this sheet)

Name of Plugging Contractor Halliburton Cementing Company
Address Liberal, Kansas

STATE OF Texas, COUNTY OF Dallas, ss.
Roy G. Walker (employee of owner) or (owner or operator) of the above-described well, being first duly sworn on oath, says: That I have knowledge of the facts, statements, and matters herein contained and the log of the above-described well as filed and that the same are true and correct. So help me God.

(Signature) Roy G. Walker
2100 Adolphus Tower, Dallas 2, Texas
(Address)

SUBSCRIBED AND SWORN TO before me this 8th day of August 19 61
Gertrude Carter
Notary Public.

My commission expires 6-1-63

