


STATE OF KANSAS
CORPORATION COMMISSION

WELL PLUGGING RECORD

Give All Information Completely
Make Required Affidavit
Mail or Deliver Report to:
Conservation Division
State Corporation Commission
800 Bitting Building
Wichita, Kansas

Seward County, Sec. 4 Twp 33S Rge. 31 (E) W (W)

Location as "NE/CNW/SW" or footage from lines SE NW
Lease Owner Edwin L. Cox
Lease Name Burr Well No. 1
Office Address 2100 Adolphus Tower, Dallas 2, Texas
Character of Well (completed as Oil, Gas or Dry Hole) Dry Hole
Date well completed Dry Hole July 15 19 61
Application for plugging filed Approval Aug 3, 1961 by phone 19
Application for plugging approved August 3, 19 61
Plugging commenced August 4, 19 61
Plugging completed August 5, 19 61
Reason for abandonment of well or producing formation Dry Hole

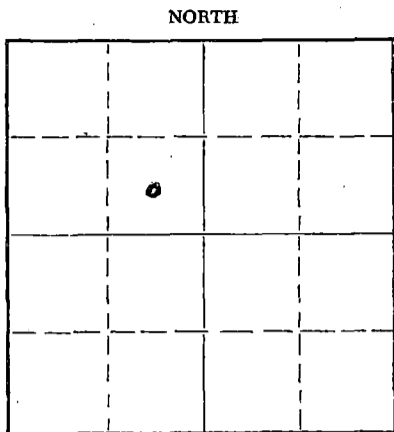

Locate well correctly on above Section Plat

If a producing well is abandoned, date of last production NA 19
Was permission obtained from the Conservation Division or its agents before plugging was commenced? Yes

Name of Conservation Agent who supervised plugging of this well Mr. Frank Broodfoot, St John, Kansas
Producing formation None Depth to top - Bottom - Total Depth of Well 4375 Feet
Show depth and thickness of all water, oil and gas formations.

OIL, GAS OR WATER RECORDS

CASING RECORD

FORMATION	CONTENT	FROM	TO	SIZE	PUT IN	PULLED OUT
	Sd, Shale, Water	2710	2760	8-5/8	2342'	None
	Water, Sand	3150	3190	2-7/8"	3267'	2584.45'
	Water, Shale	3310	3340			
	Sand, Water	4275	4360			

Describe in detail the manner in which the well was plugged, indicating where the mud fluid was placed and the method or methods used in introducing it into the hole. If cement or other plugs were used, state the character of same and depth placed, from _____ feet to _____ feet for each plug set.

2-7/8" pipestuck at 2590'. Shot off at 2585' by McCullough Tool using Chemical cutter. Halliburton circulated hole with 9.5# mud at 2555'. Placed 15 sacks from 2500' to 2555'; 20 sacks from 580' to 650'; and 20 sacks from top to 55' with some cement circulated.

RECEIVED
STATE CORPORATION COMMISSION
AUG 10 1961
CONSERVATION DIVISION
Wichita, Kansas

(If additional description is necessary, use BACK of this sheet)

Name of Plugging Contractor Halliburton Cementing Company
Address Liberal, Kansas

STATE OF Texas, COUNTY OF Dallas, ss.
Roy G. Walker (employee of owner) or (owner or operator) of the above-described

well, being first duly sworn on oath, says: That I have knowledge of the facts, statements, and matters herein contained and the log of the above-described well as filed and that the same are true and correct. So help me God

(Signature) Roy G Walker
2100 Adolphus Tower, Dallas 2, Texas
(Address)

SUBSCRIBED AND SWORN TO before me this 8th day of August, 1961

My commission expires 6-1-63

Notary Public. Gertrude Carter

