


Give All Information Completely
Make Required Affidavit
Mail or Deliver Report to:
Conservation Division
State Corporation Commission
211 No. Broadway
Wichita, Kansas

WELL PLUGGING RECORD

Seward County, Sec. 7 Twp. 33 Rge. (E) 31 (W)
C NW SW

Location as "NE/CNW%SW%" or footage from lines
Lease Owner Natural Resources Fund, Inc.
Lease Name Dudrey Well No. 1
Office Address 1776 South Jackson St. Suite 1100 Denver, Colorado
Character of Well (completed as Oil, Gas or Dry Hole) Dry Hole
Date well completed July 23 19 72
Application for plugging filed July 23 19 72
Application for plugging approved July 23 19 72
Plugging commenced July 23 19 72
Plugging completed July 23 19 72
Reason for abandonment of well or producing formation Dry Hole

NORTH

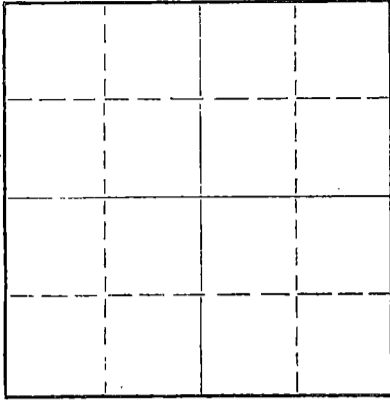

Locate well correctly on above
Section Plat

If a producing well is abandoned, date of last production 19
Was permission obtained from the Conservation Division or its agents before plugging was commenced? YES

Name of Conservation Agent who supervised plugging of this well Edgar Eves
Producing formation Depth to top Bottom Total Depth of Well Feet
Show depth and thickness of all water, oil and gas formations.

OIL, GAS OR WATER RECORDS

CASING RECORD

FORMATION	CONTENT	FROM	TO	SIZE	PUT IN	PULLED OUT
				8 5/8"	2540'	None

Describe in detail the manner in which the well was plugged, indicating where the mud fluid was placed and the method or methods used in introducing it into the hole. If cement or other plugs were used, state the character of same and depth placed, from feet to feet for each plug set.

Plug Hole-Set Cement----- Plug with 35 sx cement through DP
at 1100' plug and 1/2 sx. hulls
at 45' 15 sx. cement

RECEIVED
STATE CORPORATION COMMISSION

AUG 7 1972

CONSERVATION DIVISION
Wichita, Kansas

Name of Plugging Contractor Leben Drilling, Inc. (If additional description is necessary, use BACK of this sheet)
Address 5700 N. Portland Ave. Suite 302, Oklahoma City, OK 73112

STATE OF Oklahoma, COUNTY OF Oklahoma, ss.
Leslie Kite (owner or operator) of the above-described well, being first duly sworn on oath, says: That I have knowledge of the facts, statements, and matters herein contained and the log of the above-described well as filed and that the same are true and correct. So help me God.

(Signature) Leslie Kite

(Address)

SUBSCRIBED AND SWORN TO before me this 3rd day of August, 1972

My commission expires 5/23/76


Notary Public.



WELL LOG

Company Natural Resources Fund, Inc.
Contractor Leben Drilling, Inc.
Farm Dudrey #1
Total Depth 5729'
Commenced 7-11-72
Completed 7-23-72

Sec. 7 T.33S R. 31W
Loc. C NW SW
County Seward Co. KS
Casing 8 5/8"
Production

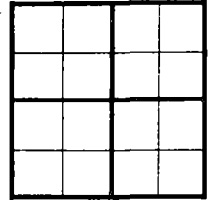

Figures Indicate Bottom of Formations

0	-	265	Sand
265	-	1145	Sand-Red Bed-Anhydrate
1145	-	1540	Red Bed-Anhydrate
1540	-	1600	Anhydrate-Shale
1600	-	2132	Shale-Anhydrate
2132	-	2395	Shale-Lime
2395	-	2648	Anhydrate-Shale
2648	-	2930	Shale & Lime
2930	-	5729	Lime & Shale

RECEIVED
STATE CORPORATION COMMISSION
AUG 7 1972
CONSERVATION DIVISION
Wichita, Kansas

State of Oklahoma
County of Oklahoma } SS

I, Leslie Kite of Leben Drilling, Inc., upon oath state that the above and foregoing is a true and correct copy of the log of the Dudrey #1 Well.

Leslie Kite

Subscribed and sworn to before me this 3rd day of August, 1972

My Commission Expires: 5/23/76
Brendal Kay Swink