


WELL PLUGGING RECORD

Give All Information Completely  
Make Required Affidavit  
Mail or Deliver Report to  
Conservation Division  
State Corporation Commission  
211 No. Broadway  
Wichita, Kansas

NORTH

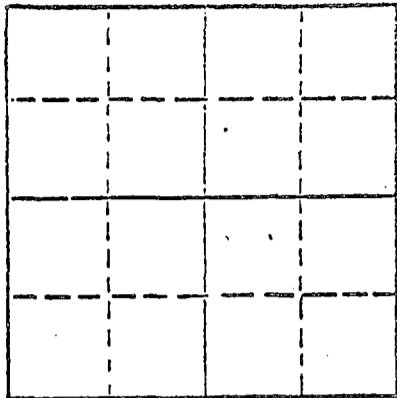

Locate well correctly on above  
Section Plat

Seward County, Sec. 16 Twp. 33S Rge. (E) 33 (W)  
Location as "NE/CNWxSWx" or footage from lines 1250' FS & W Lines  
Lease Owner Anadarko Production Company  
Lease Name Phillips "A" Well No. 1  
Office Address P. O. Box 351 Liberal, Kansas  
Character of Well (completed as Oil, Gas or Dry Hole) Dry Hole  
Date well completed 5/11 19 67  
Application for plugging filed 5/11 19 67  
Application for plugging approved 5/11 19 67  
Plugging commenced 5/11 19 67  
Plugging completed 2:00 p.m. 5/11 19 67  
Reason for abandonment of well or producing formation Dry Hole

If a producing well is abandoned, date of last production 19  
Was permission obtained from the Conservation Division or its agents before plugging was commenced? Yes

Name of Conservation Agent who supervised plugging of this well Ed Eves Sublette, Kansas  
Producing formation Depth to top Bottom Total Depth of Well 6236 Feet  
Show depth and thickness of all water, oil and gas formations.

OIL, GAS OR WATER RECORDS

CASING RECORD

FORMATION	CONTENT	FROM	TO	SIZE	PUT IN	PULLED OUT
				8-5/8"	1590'	None

Describe in detail the manner in which the well was plugged, indicating where the mud fluid was placed and the method or methods used in introducing it into the hole. If cement or other plugs were used, state the character of same and depth placed, from feet to feet for each plug set.

Laid down drill pipe to 700'. Spotted 35 sxs of cement from 700' - 600'.  
Finished laying down drill pipe. Filled hole w/mud to 45'.  
Spotted 15 sxs of cement from 45' to 0'.  
Plugged rat hole & mouse hole w/5 sxs of cement.  
Completed at 2:00 p.m. 5/11/67.

RECEIVED  
STATE CORPORATION COMMISSION

MAY 24 1967

CONSERVATION DIVISION  
Wichita, Kansas

(If additional description is necessary, use BACK of this sheet)

Name of Plugging Contractor Moran Brothers, Inc.  
Address 1200 Oil & Gas Building, Wichita Falls, Texas 76301

STATE OF Kansas COUNTY OF Seward ss.

V. K. Downey (employee of owner) or (owner or operator) of the above-described well, being first duly sworn on oath, says: That I have knowledge of the facts, statements, and matters herein contained and the log of the above-described well as filed and that the same are true and correct. So help me God.

V. K. Downey, Superintendent (Signature)  
Liberal Production Region  
P. O. Box 351 Liberal, Kansas 67901  
(Address)

Subscribed and Sworn to before me this 17th day of May 19 67.

My Commission Expires June 28, 1967  
My commission expires

Rennie L. Jackson  
Notary Public.

DRILLER'S LOG

WELL NAME: Phillips "A" #1; COMPANY OPERATING: Anadarko Production Company  
 ADDRESS of COMPANY: Box 351 Liberal, Kansas

WELL LOCATION: 1/4 SW 1/4 SW 1/4,  
1250 ft. North of South line,  
1250 ft. East of West line; Sec. 16, Twp. 33S, Rge. 33W, Seward County, Kansas

DRILLING STARTED 4/28, 1967; DRILLING COMPLETED 5/11, 1967  
 WELL COMPLETED \_\_\_\_\_, 19\_\_\_\_; WELL CONNECTED \_\_\_\_\_, 19\_\_\_\_

ELEVATION: 2849.3 ft. Ground Level; CHARACTER OF WELL (Oil, Gas, or Dry Hole) Dry Hole

OIL OR GAS SANDS OR ZONES - PERFORATIONS - ACIDIZING AND FRACTURING INFORMATION					
Name	From	To	No. of Shots	Gallons Used	Kind Used

RECEIVED  
 STATE CORPORATION COMMISSION  
 MAY 24 1967  
 CONSERVATION DIVISION  
 Topeka, Kansas

CASING RECORD

Size	Amount Set	Sacks of Cement	Amount Pulled
8-5/8"	1590'	725	None

FORMATION RECORD

Formation	Top	Bottom	Formation	Top	Bottom
Sand & Clay	0	360	Shale, Lime & Sand	5945	6125
Sand, Clay & Red Bed	360	1205	Lime & Shale	6185	6193
Red Bed	1205	1590	Lime	6193	6236
Anhydrite & Red Bed	1590	1790	R.T.D.		6236
Red Bed & Shale	1790	2330			
Shale & Lime	2330	2555			
Lime & Shale	2555	3565			
Lime, Shale w/Chalk	3565	3878			
Lime & Shale	3878	4523			
Lime	4523	5505			
Lime, Shale w/Sand	5505	5632			
Sand, Lime & Shale	5632	5832			
Shale & Lime	5832	5945			

RESULTS of INITIAL PRODUCTION TEST: Plugged & Abandoned on May 11, 1967.