

15-189-00488-00-00


STATE OF KANSAS
STATE CORPORATION COMMISSION

Form CP-4

WELL PLUGGING RECORD

Give All Information Completely
Make Required Affidavit
Mail or Deliver Report to:
Conservation Division
State Corporation Commission
212 No. Market
Wichita, Kansas

NORTH

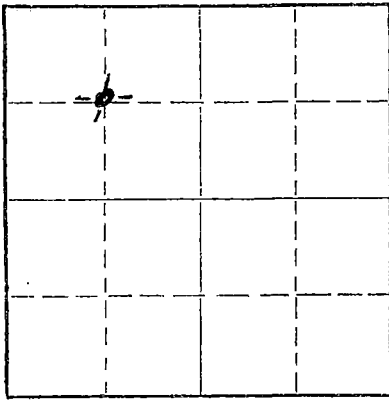

Locate well correctly on above
Section Plat

Stevens County, Sec. 14 Twp. 33 Rge. 39 (E) (W)

Location as "NE/CNW/SW" or footage from lines Center NW/4

Lease Owner Ashland Oil & Refining Company

Lease Name J. A. Christopher Well No. 1

Office Address P.O. Box 127 Satanta, Kansas 67870

Character of Well (completed as Oil, Gas or Dry Hole) Gas

Date well completed June 11, 19 36

Application for plugging filed January 7, 19 69

Application for plugging approved January 8, 19 69

Plugging commenced January 22, 19 69

Plugging completed January 24, 19 69

Reason for abandonment of well or producing formation

Well replaced with the J. A. Christopher #5

If a producing well is abandoned, date of last production August, 19 59

Was permission obtained from the Conservation Division or its agents before plugging was commenced? Yes

Name of Conservation Agent who supervised plugging of this well Edgar Eves - Box F - Sublette, Kansas

Producing formation Chase Group Depth to top Bottom Total Depth of Well 2652 Feet

Show depth and thickness of all water, oil and gas formations.

OIL, GAS OR WATER RECORDS

CASING RECORD

FORMATION	CONTENT	FROM	TO	SIZE	PUT IN	PULLED OUT
Chase Group	Gas	0	2652	1 1/2"	2652	2652
Chase Group	Gas	0	2440	7" OD	2440	1207'
				5 1/2"	262	-0-

Describe in detail the manner in which the well was plugged, indicating where the mud fluid was placed and the method or methods used in introducing it into the hole. If cement or other plugs were used, state the character of same and depth placed, from feet to feet for each plug set.

13 3/8" to 505' Circulated w/cement
 7" to 2440' Cemented
 5 1/2" Liner 2390' to 2652'
 Plugged bottom with 25 sacks cement
 Top of cement 2340'
 Mud 2340' to 525'
 Spotted 25 sacks of cement 525' to 400'
 Mud 400' to 30'
 Plug, hulls and 15 sacks of cement 30' to 0'
 Company pump.

RECEIVED
STATE CORPORATION COMMISSION
JAN 30 1969
CONSERVATION DIVISION
Wichita, Kansas

(If additional description is necessary, use BACK of this sheet)

Name of Plugging Contractor Sargents Casing Pulling Company

Address P.O. Box 506 - Liberal, Kansas License No. 511

STATE OF Kansas, COUNTY OF Haskell, ss.
Felix C. Turley (employee of owner) or (owner or operator) of the above-described

well, being first duly sworn on oath, says: That I have knowledge of the facts, statements, and matters herein contained and the log of the above-described well as filed and that the same are true and correct. So help me God.

(Signature) Felix C. Turley

P.O. Box 127 - Satanta, Kansas 67870 (Address)

SUBSCRIBED AND SWORN TO before me this 28th day of January, 19 69

My commission expires October 1, 1970

H. T. Ungler Notary Public.