


Give All Information Completely
Make Required Affidavit
Mail or Deliver Report to:
Conservation Division
State Corporation Commission
212 No. Market
Wichita, Kansas

WELL PLUGGING RECORD

NORTH

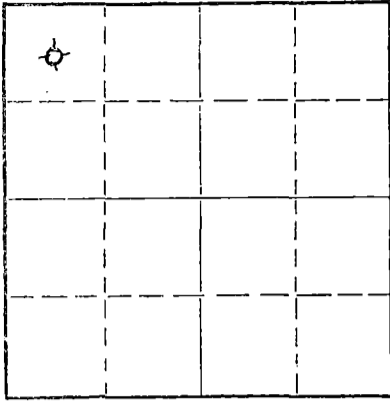

Locate well correctly on above
Section Plat

Seward County. Sec. 23 Twp. 33S Rge. (E)-33-(W)
Location as "NE/CNW%SW%" or footage from lines C NW NW
Lease Owner Coral Gas and Oil, Inc.
Lease Name Hunt Well No. 1
Office Address 409 Bank of Southwest Bldg., Amarillo, Tex. 79109
Character of Well (completed as Oil, Gas or Dry Hole) Gas
Date well completed January 17, 1970
Application for plugging filed October 12, 1970
Application for plugging approved October 13, 1970
Plugging commenced November 27, 1970
Plugging completed November 27, 1970
Reason for abandonment of well or producing formation Production ceased

If a producing well is abandoned, date of last production July, 1970
Was permission obtained from the Conservation Division or its agents before plugging was commenced? Yes

Name of Conservation Agent who supervised plugging of this well _____
Producing formation Morrow Depth to top 5701 Bottom 5846 Total Depth of Well 6207 Feet
Show depth and thickness of all water, oil and gas formations.

OIL, GAS OR WATER RECORDS

CASING RECORD

FORMATION	CONTENT	FROM	TO	SIZE	PUT IN	PULLED OUT
Clay & sd		0	40	8-5/8	1560	None
Sh & Red Bed		40	1220	4-1/2	6163	3477
Glorietta	Water	1220	1530			
Sh & Anhy		1530	3175			
Lime & sh		3175	5665			
Sh, lm & sd	Gas	5665	6207			

Describe in detail the manner in which the well was plugged, indicating where the mud fluid was placed and the method or methods used in introducing it into the hole. If cement or other plugs were used, state the character of same and depth placed, from _____ feet to _____ feet for each plug set.

Pumped mud from PBTD 5775' to 5706'. Mixed and pumped 20 sacks cement with plug from 5706' to 5512'. Pumped mud to 1600'. Spotted 35 sacks cement from 1600' to 1500'. Pumped mud to 50'. Ran 15 sacks cement from 50' to 5'.

RECEIVED
STATE CORPORATION COMMISSION
DEC 21 1970
CONSERVATION DIVISION
Wichita, Kansas

(If additional description is necessary, use BACK of this sheet)

Name of Plugging Contractor Daco Lease & Well Service
Address 1700 South Main, Borger, Texas 79007

STATE OF Texas, COUNTY OF Potter, ss.
Bryan Dawson ~~XXXXXX~~ (owner or operator) of the above-described well, being first duly sworn on oath, says: That I have knowledge of the facts, statements, and matters herein contained and the log of the above-described well as filed and that the same are true and correct. So help me God.

(Signature) Bryan Dawson
409 Bank of the Southwest Building
(Address) Amarillo, Texas

SUBSCRIBED AND SWORN TO before me this 15th day of December, 19 70

My commission expires June 1, 1971

Notary Public.