

STATE OF KANSAS  
STATE CORPORATION COMMISSION

WELL PLUGGING RECORD

Give All Information Completely  
Make Required Affidavit  
Mail or Deliver Report to:  
Conservation Division  
State Corporation Commission  
800 Bittling Building  
Wichita, Kansas

Seward

County. Sec. 23 Twp. 33S Rge. 33W (E) (W)

Location as "NE/CNW $\frac{1}{4}$ SW $\frac{1}{4}$ " or footage from lines 100'N & 100'W of Center of Sec

Lease Owner American Gas Production Company

Lease Name Hunt "C" #1

Well No. 1

Office Address Bartlesville, Oklahoma

Character of Well (completed as Oil, Gas or Dry Hole)

Date well completed 19

Application for plugging filed 4-20-1951 19

Application for plugging approved 4-21-1951 19


Plugging commenced 4-21-1951 19

Plugging completed 4-21-1951 19

Reason for abandonment of well or producing formation\* The tubing was cemented in the hole while attempting to shut off water

If a producing well is abandoned, date of last production 19

Was permission obtained from the Conservation Division or its agents before plugging was commenced? Yes

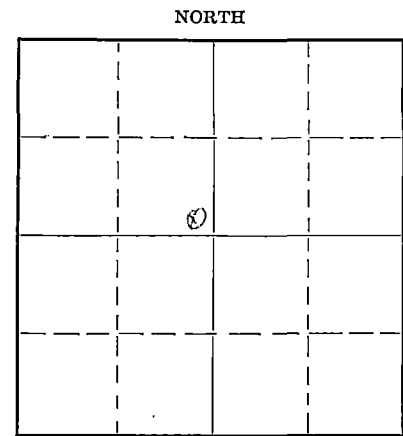

Locate well correctly on above Section Plat

Name of Conservation Agent who supervised plugging of this well R. J. Phillipe

Producing formation Depth to top Bottom Total Depth of Well 2770' Feet

Show depth and thickness of all water, oil and gas formations.

OIL, GAS OR WATER RECORDS

CASING RECORD

Formation	Content	From	To	Size	Put In	Pulled Out
Herrington		2600	2612	8-5/8"	639	None
U-Krider		2628	2636	5 1/2"	2769	None
L-Krider		2664	2684			

Describe in detail the manner in which the well was plugged, indicating where the mud fluid was placed and the method or methods used in introducing it into the hole. If cement or other plugs were used, state the character of same and depth placed, from feet to feet for each plug set.

The casing was filled with heavy mud from the top of the cement (at 2227') to 20' below the surface. A wooden plug was driven in the 5 1/2" casing to 20' and the remainder was filled up with cement. A steel cap was welded on the 5 1/2" casing

\* The rig was skidded 100'S & 100'E of center on same section

(If additional description is necessary, use BACK of this sheet)

Correspondence regarding this well should be addressed to H. V. Anderson  
Address Box 70, Liberal, Kansas

STATE OF Kansas, COUNTY OF Seward, ss.

(employee of owner) or (owner or operator) of the above-described well, being first duly sworn on oath, says: That I have knowledge of the facts, statements, and matters herein contained and the log of the above-described well as filed and that the same are true and correct. So help me God.

(Signature) H.V. Anderson  
Liberal Kan  
(Address)

SUBSCRIBED AND SWORN to before me this 7th day of May, 19 51

RECEIVED  
STATE CORPORATION COMMISSION

J. T. Mahrey  
Notary Public.

My commission expires 5-23-1953 MAY 9 - 1951 22-7877-s 4-40-10M

CONSERVATION  
WELL PLUGGING  
FILE SEC 23 T 33 R 33W  
BOOK PAGE 75 LINE 23