


Give All Information Completely
Make Required Affidavit
Mail or Deliver Report to:
Conservation Division
State Corporation Commission
211 No. Broadway
Wichita, Kansas

WELL PLUGGING RECORD

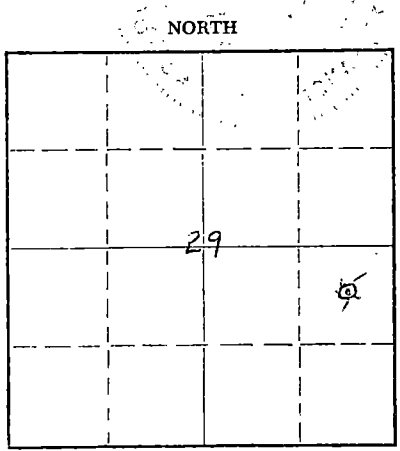

SEWARD County. Sec. 29 Twp. 33S Rge. 33 (X) W (W)
Location as "NE/CNW/SW" or footage from lines C NE SE
Lease Owner MALLONEE-MAHONEY, INC.
Lease Name PREIFERT Well No. 1
Office Address 925 SUTTON PLACE, WICHITA, KANSAS 67202
Character of Well (completed as Oil, Gas or Dry Hole) D & A
Date well completed 6-12 1970
Application for plugging filed 6-12 1970
Application for plugging approved 6-12 1970
Plugging commenced 6-12 1970
Plugging completed 6-12 1970
Reason for abandonment of well or producing formation DRY HOLE

If a producing well is abandoned, date of last production 19
Was permission obtained from the Conservation Division or its agents before plugging was commenced? YES

Name of Conservation Agent who supervised plugging of this well ED EVES
Producing formation _____ Depth to top _____ Bottom _____ Total Depth of Well 6,336 Feet
Show depth and thickness of all water, oil and gas formations.

OIL, GAS OR WATER RECORDS

CASING RECORD

| FORMATION | CONTENT | FROM | TO | PULLED OUT |
|-----------|---------|------|----|------------|
| | | | | |
| | | | | |
| | | | | |
| | | | | |
| | | | | |
| | | | | |

RECEIVED
STATE CORPORATION COMMISSION IN
JUN 16 1970
CONSERVATION DIVISION
Wichita, Kansas

Describe in detail the manner in which the well was plugged, indicating where the mud fluid was placed and the method or methods used in introducing it into the hole. If cement or other plugs were used, state the character of same and depth placed, from _____ feet to _____ feet for each plug set.

CEMENTED WITH 35 SX COMMON @ 1,000', 15 SX COMMON FROM 45' TO 0'


(If additional description is necessary, use BACK of this sheet)

Name of Plugging Contractor ZENITH DRILLING CORPORATION
Address WICHITA, KANSAS

STATE OF KANSAS, COUNTY OF SEWARD, ss.
I, T. W. MAHONEY (employee of owner) (owner or operator) of the above-described well, being first duly sworn on oath, says: That I have knowledge of the facts, statements, and matters herein contained and the log of the above-described well as filed and that the same are true and correct. So help me God.

(Signature) T. W. Mahoney
Box 1257, LIBERAL, KANSAS 67901
(Address)

SUBSCRIBED AND SWORN to before me this 15TH day of JUNE, 1970

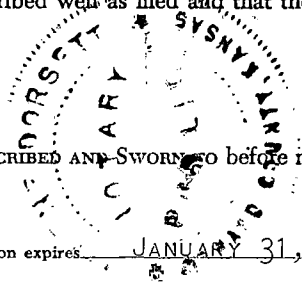

John S. Sarsett
Notary Public.

My commission expires JANUARY 31, 1971

WELL LOG

COMPANY Mallonee-Mahoney, Inc.

SEC. 29-33S-33W

FARM Preifert

NO. 1

LOC. C-NE-SE

TOTAL DEPTH 6445 ft.

COUNTY Seward

COMM. May 26, 1970

COMP. June 12, 1970

CONTRACTOR Zenith Drilling Corporation, Inc.

| | | | |
|--|--|--|---|
| | | | |
| | | | |
| | | | X |
| | | | |

CASING

8 5/8" @ 1,354' W/775 sx.

ELEVATION

PRODUCTION D & A

FIGURES INDICATE BOTTOM OF FORMATIONS

1345 Red Bed & Andhy.

2100 Shale & Red Bed

2871 Red Beds & Andhy,

2985 Lime

3210 Dolomite

3400 Lime

4302 Dolomite

5409 Lime.

5456 Lime & Shale

5890 Shale

6190 Shale & Lime

6445 Lime

TD

RECEIVED
STATE CORPORATION COMMISSION
JUN 23 1970
CONSERVATION DIVISION
Wichita, Kansas

State of Kansas }
County of Sedgwick } SS

I, C. Robert Buford of Wichita, Kansas

upon oath state the above and foregoing is a true and correct copy of the log of the Preifert #1 well.

C. Robert Buford

Subscribed and sworn to before me this 16 day of June, 19 70

My Commission Expires: Aug. 15, 1971

Myrna S. Murphy
NOTARY PUBLIC