


STATE OF KANSAS
STATE CORPORATION COMMISSION

WELL PLUGGING RECORD

Give All Information Completely
Make Required Affidavit
Mail or Deliver Report to:
Conservation Division
State Corporation Commission
211 No. Broadway
Wichita, Kansas

Seward County, Sec. 33 Twp. 33 Rge. (E) 33 (W)

Location as "NE/CNW/SW" or footage from lines _____
Lease Owner Falcon Seaboard Drilling Company
Lease Name Salley Well No. 2
Office Address Pan American Building, Tulsa, Oklahoma
Character of Well (completed as Oil, Gas or Dry Hole) Dry Hole
Date well completed July 19 19 63
Application for plugging filed July 19 19 63
Application for plugging approved July 19 19 63
Plugging commenced July 19 19 63
Plugging completed July 19 19 63
Reason for abandonment of well or producing formation _____

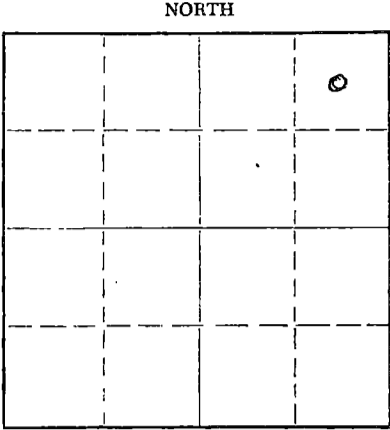

Locate well correctly on above
Section Plat

If a producing well is abandoned, date of last production _____ 19____
Was permission obtained from the Conservation Division or its agents before plugging was commenced? Yes

Name of Conservation Agent who supervised plugging of this well Hugh Scott
Producing formation _____ Depth to top _____ Bottom _____ Total Depth of Well 6275 Feet
Show depth and thickness of all water, oil and gas formations.

OIL, GAS OR WATER RECORDS

CASING RECORD

FORMATION	CONTENT	FROM	TO	SIZE	PUT IN	PULLED OUT
				8-5/8"	1600	None

Describe in detail the manner in which the well was plugged, indicating where the mud fluid was placed and the method or methods used in introducing it into the hole. If cement or other plugs were used, state the character of same and depth placed, from _____ feet to _____ feet for each plug set.
to 6177';
Set 25-sack cement plug 6260' to 5777';
Set 35-sack cement plug 750' to 620'; Set 15-sack cement plug 0' to 40'.
Welded steel cap on top of surface casing.

RECEIVED
STATE CORPORATION COMMISSION

JUL 26 1963

CONSERVATION DIVISION
Wichita, Kansas

(If additional description is necessary, use BACK of this sheet)
Name of Plugging Contractor Company Tools & Halliburton Company
Address _____

STATE OF OKLAHOMA, COUNTY OF TULSA, ss.
J. O. Brown (employee of owner) or (owner or operator) of the above-described well, being first duly sworn on oath, says: That I have knowledge of the facts, statements, and matters herein contained and the log of the above-described well as filed and that the same are true and correct. So help me God.

(Signature) J. O. Brown
805 Pan American Building, Tulsa, Oklahoma

SUBSCRIBED AND SWORN TO before me this 25th day of July, 1963

My commission expires April 6, 1967
Kathryne Donohoo Notary Public.