


STATE OF KANSAS  
STATE CORPORATION COMMISSION

WELL PLUGGING RECORD

Give All Information Completely  
Make Required Affidavit  
Mail or Deliver Report to  
Conservation Division  
State Corporation Comm.  
245 North Water  
Wichita, KS 67202

Seward County. Sec. 36 Twp. 33 Rge. 33 E/W  
Location as "NE/CNW $\frac{1}{4}$ SW $\frac{1}{4}$ " or footage from lines  
C SW SW

Lease Owner Anadarko Production Company  
Lease Name BRYANT "B" Well No. 1  
Office Address P. O. Box 351, Liberal, Kansas 67901  
Character of Well (Completed as Oil, Gas or Dry Hole)

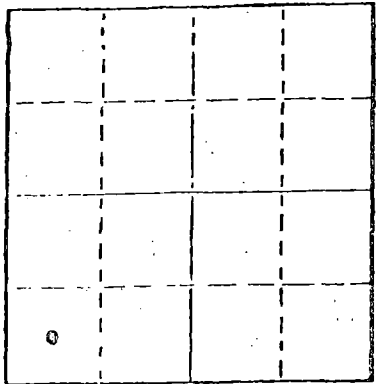

Dry Hole  
Date Well completed 1/22 1981  
Application for plugging filed verbally 1/22 1981  
Application for plugging approved verbally 1/22 1981  
Plugging commenced 1/22 1981  
Plugging completed 1/22 1981  
Reason for abandonment of well or producing formation

Dry Hole  
If a producing well is abandoned, date of last production 19

Was permission obtained from the Conservation Division or its agents before plugging was commenced? yes

Name of Conservation Agent who supervised plugging of this well Clarence Thomas  
Producing formation Depth to top Bottom Total Depth of Well 6500'  
Show depth and thickness of all water, oil and gas formations.

OIL, GAS OR WATER RECORDS

CASING RECORD

FORMATION	CONTENT	FROM	TO	SIZE	PUT IN	PULLED OUT
				8-5/8"	1566'	0

Describe in detail the manner in which the well was plugged, indicating where the mud fluid was placed and the method or methods used in introducing it into the hold. If cement or other plugs were used, state the character of same and depth placed, from feet to feet for each plug set. Spotted 60 sxs cmt @ 1580', 25 sxs @ 700', 10 sxs 40-0', 5 sxs Rathole, 5 sxs Mousehole, w/hvy mud between all plugs.

(If additional description is necessary, use BACK of this sheet)

Name of Plugging Contractor Johnson Drilling Co.

STATE OF KANSAS COUNTY OF SEWARD, ss.  
Paul Campbell (employee of owner) or (owner or operator)

of the above-described well, being first duly sworn on oath, says: That I have knowledge of the facts, statements, and matters herein contained and the log of the above-described well as filed and that the same are true and correct. So help me God.

(Signature) Paul Campbell by J.R. Smith  
P. O. Box 351 Liberal, Kansas 67901  
(Address)

SUBSCRIBED AND SWORN TO before me this 24th day of March, 1981

STATE NOTARY PUBLIC  
BEVERLY J. WILLIAMS  
Seward County, Kansas  
My Appt. Exp. 11/21/82

(Signature) Beverly J. Williams  
Notary Public.

My commission expires November 21, 1982

RECEIVED  
STATE CORPORATION COMMISSION

MAR 26 1981

CONSERVATION DIVISION  
Wichita, Kansas