15-175-20673-0000


Form CP-4
Rev. 12-15-80

STATE OF KANSAS
STATE CORPORATION COMMISSION
200 Colorado Derby Bldg.
Wichita, Kansas 67202

# WELL PLUGGING RECORD

Give All Information Completely
Make Required Affidavit

COUNTY Seward SEC. 17 TWP. 33 RGE. 31 ~~E~~/W
Location as in quarters or footage from lines:
SE SE SW

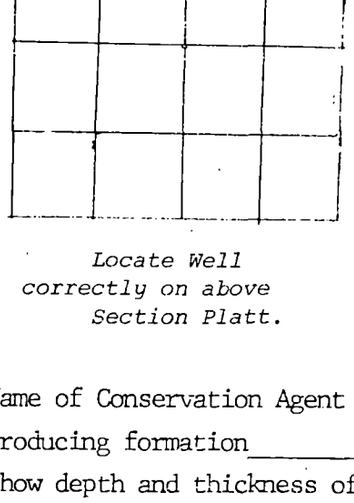

*Locate Well correctly on above Section Platt.*

Lease Owner Merit Energy Corporation
Lease Name Shelman Well No. 1-17
Office Address 717 Seventeenth Street, Suite 1750, Denver, CO 80202
Character of Well (Completed as Oil, Gas or Dry Hole): Dry Hole
Date Well Completed January 20, 1983
Application for plugging filed Verbal application
Plugging commenced January 20, 1983
Plugging completed January 20, 1983
Reason for abandonment of well or producing formation
Dry Hole
Was permission obtained from the Conservation Division or it's Agent's before plugging was commenced? Yes

Name of Conservation Agent who supervised plugging of this well Robert Tarbutton
Producing formation _____ Depth to top _____ bottom _____ T.D. 6120'
Show depth and thickness of all water, oil and gas formations.

OIL, GAS OR WATER RECORDS — Casing Record

| Formation | Content | From | To | Size | Put in | Pulled Out |
|---|---|---|---|---|---|---|
| | | | | 8-5/8" | 1600' | none |
| | | | | | | |
| | | | | | | |
| | | | | | | |
| | | | | | | |

Describe in detail the manner in which the well was plugged, indicating where the mud fluid was placed and the method or methods used in introducing it into the hold. If cement or other plugs were used, state the character of same and depth placed, from _____ feet to _____ feet for each plug set.

1653' - 70 sxs
900' - 40 sxs
40' - 10 sxs
R.H. - 10 sxs
M.H. - 10 sxs

(If additional description is necessary, use BACK of this sheet)
Name of Plugging Contractor Sun Oilwell Cementing, Inc.
Box 27, Oakley, KS 67748

STATE OF Kansas COUNTY OF Sedgwick, ss.
Diane Rebstock (~~employee~~ of owner) or (~~owner or operator~~) of the above-described well, being first duly sworn on oath, says: That I have knowledge of the facts, statements, and matters herein contained and the log of the above-described well as filed and that the same are true and correct. So help me God.

(Signature) Diane Rebstock
251 N. Water, #10, Wichita, Ks.
(Address) 67202

SUBSCRIBED AND SWORN TO before me this 22nd day of February, 1983

COLEEN B. THOMAS
Sedgwick County, Ks.
My Appt. Exp. 5/12/84

Coleen B. Thomas
Notary Public.

My Commission expires: May 12, 1984

RECEIVED
STATE CORPORATION COMMISSION
MAR 1 1983
CONSERVATION DIVISION
Wichita, Kansas