


STATE OF KANSAS
STATE CORPORATION COMMISSION

WELL PLUGGING RECORD

Give All Information Completely
Make Required Affidavit
Mail or Deliver Report to
Conservation Division
State Corporation Comm.
245 North Water
Wichita, KS 67202

Seward County, Sec. 20 Twp. 33S Rge. 34 ~~XE~~/W
Location as "NE/CNW $\frac{1}{4}$ SW $\frac{1}{4}$ " or footage from lines _____
C SE SE

Lease Owner Anadarko Production Company
Lease Name GUTTRIDGE "D" Well No. 2
Office Address P. O. Box 351, Liberal, Kansas 67901
Character of Well (Completed as Oil, Gas or Dry Hole) _____
Dry Hole

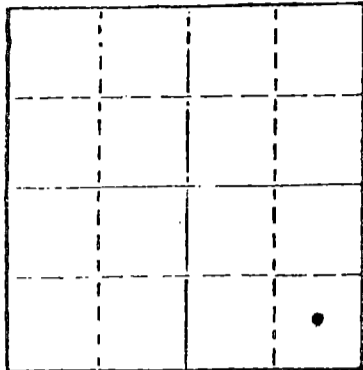

Locate well correctly on above
Section Plat

Date Well completed 3-2 1979
Application for plugging filed 3-22 1979
Application for plugging approved verbally 3-2 1979
Plugging commenced 3-2 1979
Plugging completed 3-2 1979
Reason for abandonment of well or producing formation _____
Dry Hole

If a producing well is abandoned, date of last production _____ 19 _____

Was permission obtained from the Conservation Division or its agents before plugging was commenced? yes

Name of Conservation Agent who supervised plugging of this well Clarence Thomas, Jr.
Producing formation _____ Depth to top _____ Bottom _____ Total Depth of Well 6330
Show depth and thickness of all water, oil and gas formations.


OIL, GAS OR WATER RECORDS

CASING RECORD

FORMATION	CONTENT	FROM	TO	SIZE	PUT IN	PULLED OUT
				8-5/8"	1685	None

Describe in detail the manner in which the well was plugged, indicating where the mud fluid was placed and the method or methods used in introducing it into the hold. If cement or other plugs were used, state the character of same and depth placed, from _____ feet to _____ feet for each plug set.

Spotted 50 sxs cmt @ 1600', 10 sxs 40-0, 5 sxs rathole & 5 sxs mousehole w/hvy mud between all plugs.

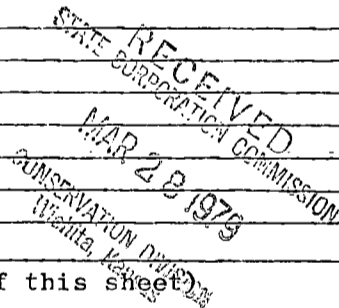

(If additional description is necessary, use BACK of this sheet)

Name of Plugging Contractor Lohmann-Johnson Drilling Co., Inc.

STATE OF KANSAS COUNTY OF SEWARD, ss.
Paul Campbell (employee of owner) or ~~xxxxxx~~
of the above-described well, being first duly sworn on oath, says: That I have knowledge of the facts, statements, and matters herein contained and the log of the above-described well as filed and that the same are true and correct. So help me God.


(Signature)

Paul Campbell

P. O. Box 351, Liberal, Kansas 67901

(Address)

SUBSCRIBED AND SWORN TO before me this 27th day of March, 1979

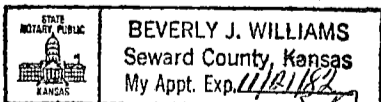

My commission expires

November 21, 1982

Beverly J. Williams
Notary Public.

15-175-203960000

KANSAS DRILLERS LOG

API No. 15 — 175 — 20-396
 County Number

Operator
Anadarko Production Company

Address
Liberal, Kansas 67901

Well No. 2 Lease Name GUTTRIDGE "D"

Footage Location
660 feet from ~~XXX~~ (S) line 660 feet from (E) ~~XX~~ line

Principal Contractor Lohmann-Johnson Drilling Co. Geologist J. G. Blair

Spud Date 2/16/79 Total Depth 6330 P.B.T.D.


Date Completed 3/2/79 Oil Purchaser

S. 20 T. 33S R. 34 ^{XE} W

Loc. C SE SE

County Seward

640 Acres
 N

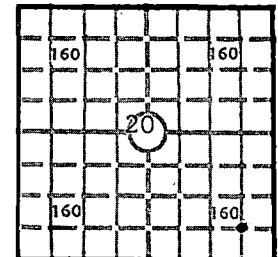

Elev.: Gr. 2931

DF _____ KB _____

CASING RECORD

Report of all strings set — surface, intermediate, production, etc.

Purpose of string	Size hole drilled	Size casing set (in O.D.)	Weight lbs/ft.	Setting depth	Type cement	Sacks	Type and percent additives
Surface	12-1/4"	8-5/8"	24#	1685	Poz Common	550 200	4% Gel 2% CaCl 3% CaCl

LINER RECORD

PERFORATION RECORD

Top, ft.	Bottom, ft.	Sacks cement	Shots per ft.	Size & type	Depth interval

TUBING RECORD

Size	Setting depth	Packer set at

ACID, FRACTURE, SHOT, CEMENT SQUEEZE RECORD

Amount and kind of material used

Depth interval treated
RECEIVED
 STATE CORPORATION COMMISSION
MAR 28 1979
 CONSERVATION DIVISION
 Wichita, Kansas

INITIAL PRODUCTION

Date of first production Dry Hole Producing method (flowing, pumping, gas lift, etc.)

RATE OF PRODUCTION PER 24 HOURS
 Oil _____ bbls. Gas _____ MCF Water _____ bbls. Gas-oil ratio _____ CFPB

Disposition of gas (vented, used on lease or sold) _____ Producing interval (s) _____

INSTRUCTIONS: As provided in KCC Rule 82-2-125, within 90 days after completion of a well, one completed copy of this Drillers Log shall be transmitted to the State Geological Survey of Kansas, 4150 Monroe Street, Wichita, Kansas 67209. Copies of this form are available from the Conservation Division, State Corporation Commission, 3830 So. Meridian (P.O. Box 17027), Wichita, Kansas 66217. Phone AC 316-522-2206. If confidential custody is desired, please note Rule 82-2-125. Drillers Logs will be on open file in the Oil and Gas Division, State Geological Survey of Kansas, Lawrence, Kansas 66044.

Operator Anadarko Production Company		DESIGNATE TYPE OF COMP.: OIL, GAS, DRY HOLE, SWDW, ETC.:
Well No. 2	Lease Name GUTTRIDGE "D"	Dry Hole
S 20 T 33S R 34 33 W		


WELL LOG

Show all important zones of porosity and contents thereof; cored intervals, and all drill-stem tests, including depth interval tested, cushion used, time tool open, flowing and shut-in pressures, and recoveries.

SHOW GEOLOGICAL MARKERS, LOGS RUN, OR OTHER DESCRIPTIVE INFORMATION.

FORMATION DESCRIPTION, CONTENTS, ETC.	TOP	BOTTOM	NAME	DEPTH
Sand	0'	304'	Logs: Schlumberger Dual Induction-SFL	
Sand & Clay	304'	540'		
Redbed & Sand	540'	1095'	6324-19'	
Glorietta	1095'	1315'	Comp. Neut.-F.D.	
Redbed, Shale	1315'	1600'	6329-19'	
Shale	1600'	1645'		
Redbed	1645'	1683'		
Anhydrite	1683'	1687'		
Shale	1687'	2910'		
Lime, Shale	2910'	6330'		
Cored 6235-6270, rec 34'.				
DST #1 6200-6330 (Chester) 15-90-45-120 Johnson tele flow, rec 30' drlg mud, IFP 85-85, ISIP 198, FFP 98-98, FSIP 160, HP 2958-2920, BHT 131 deg.				

USE ADDITIONAL SHEETS, IF NECESSARY, TO COMPLETE WELL RECORD.

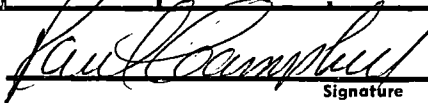Date Received	
	Signature
	Paul Campbell, Division Production Manager
	Title
	March 22, 1979
	Date