


STATE OF KANSAS  
STATE CORPORATION COMMISSION

WELL PLUGGING RECORD

Give All Information Completely  
Make Required Affidavit  
Mail or Deliver Report to  
Conservation Division  
State Corporation Comm.  
245 North Water  
Wichita, KS 67202

Seward County, Sec. 22 Twp. 33S Rge. 34 ~~XX~~/W  
Location as "NE/CNW 1/4 SW 1/4" or footage from lines  
1980 FWL & 660 FNL

Lease Owner Anadarko Production Company  
Lease Name PITMAN "A" Well No. 2  
Office Address P. O. Box 351, Liberal, Kansas 67901  
Character of Well (Completed as Oil, Gas or Dry Hole)  
Dry Hole

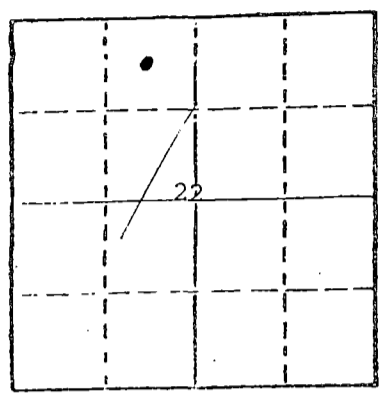

Locate well correctly on above  
Section Plot

Date Well completed 2-10 1979  
Application for plugging filed 3-5 1979  
Application for plugging approved verably 2-10 1979  
Plugging commenced 2-10 1979  
Plugging completed 2-10 1979  
Reason for abandonment of well or producing formation  
Dry

If a producing well is abandoned, date of last production  
19

Was permission obtained from the Conservation Division or  
its agents before plugging was commenced? yes

Name of Conservation Agent who supervised plugging of this well Clarence Thomas  
Producing formation \_\_\_\_\_ Depth to top \_\_\_\_\_ Bottom \_\_\_\_\_ Total Depth of Well 6415'  
Show depth and thickness of all water, oil and gas formations.

OIL, GAS OR WATER RECORDS

CASING RECORD

FORMATION	CONTENT	FROM	TO	SIZE	PUT IN	PULLED OUT
				8-5/8"	1667	None

Describe in detail the manner in which the well was plugged, indicating where the mud fluid  
was placed and the method or methods used in introducing it into the hold. If cement or other  
plugs were used, state the character of same and depth placed, from \_\_\_\_\_ feet to  
\_\_\_\_\_ feet for each plug set.

Spotted 40 sxs cmt 2800, 40 sxs cmt 2500, 50 sxs cmt 1600, 10 sxs cmt 40-3, 5 sxs cmt  
rathole, 5 sxs cmt mousehole w/hvy mud between all cmt plugs.

RECEIVED  
STATE CORPORATION COMMISSION  
MAD  
- 8 1979  
CONSERVATION DIVISION  
Wichita, Kansas

(If additional description is necessary, use BACK of this sheet)  
Name of Plugging Contractor Lohmann-Johnson Drilling Co., Inc.

STATE OF KANSAS COUNTY OF SEWARD, ss.  
Paul Campbell (employee of owner) or ~~XXXXXXXXXXXXXXXXXXXX~~

of the above-described well, being first duly sworn on oath, says: That I have knowledge of  
the facts, statements, and matters herein contained and the log of the above-described well  
as filed and that the same are true and correct. So help me, God.

Bobby M. Tillman  
State Notary Public  
Sumner Co. Kansas

(Signature) Paul Campbell  
P. O. Box 351, Liberal, Kansas 67901  
(Address)

MY COMMISSION EXPIRES APRIL 1, 1979  
SUBSCRIBED AND SWORN TO before me this 6th day of March, 19 79

My commission expires 4-1-79

Bobby M. Tillman  
Notary Public.

**KANSAS DRILLERS LOG**


API No. 15 — 175 — 20,392  
 County Number

S. 22 T. 33S R. 34 W

Loc. C NE NW

County Seward

640 Acres  
N

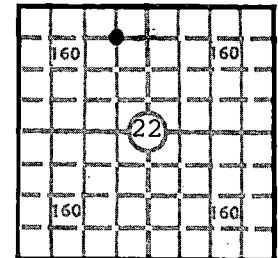

Locate well correctly

Elev.: Gr. 2890.3

DF \_\_\_\_\_ KB \_\_\_\_\_

Operator  
Anadarko Production Company

Address  
P. O. Box 351, Liberal, Kansas 67901

Well No. 2 Lease Name PITMAN "A"

Footage Location  
660 feet from (N) line 1980 feet from (W) line

Principal Contractor Lohmann-Johnson Drilling Co. Geologist

Spud Date 1-28-79 Total Depth 6415 P.B.T.D.

Date Completed 2-10-79 Oil Purchaser

**CASING RECORD**

Report of all strings set — surface, intermediate, production, etc.

Purpose of string	Size hole drilled	Size casing set (in O.D.)	Weight lbs/ft.	Setting depth	Type cement	Sacks	Type and percent additives
Surface	12-1/4"	8-5/8"	24#	1667	Poz Common	550 200	4% Gel 2% CaCl 3% CaCl

**LINER RECORD**

**PERFORATION RECORD**

Top, ft.	Bottom, ft.	Sacks cement	Shots per ft.	Size & type	Depth interval

**TUBING RECORD**

Size	Setting depth	Packer set at

**ACID, FRACTURE, SHOT, CEMENT SQUEEZE RECORD**

Amount and kind of material used	Depth interval treated

**INITIAL PRODUCTION**

Date of first production Dry Hole Producing method (flowing, pumping, gas lift, etc.)

RATE OF PRODUCTION PER 24 HOURS  
 Oil \_\_\_\_\_ Gas \_\_\_\_\_ Water \_\_\_\_\_ Gas-oil ratio \_\_\_\_\_  
 bbls. MCF bbls. CFPB

Disposition of gas (vented, used on lease or sold) Producing interval (s)

INSTRUCTIONS: As provided in KCC Rule 82-2-125, within 90 days after completion of a well, one completed copy of this Drillers Log shall be transmitted to the State Geological Survey of Kansas, 4150 Monroe Street, Wichita, Kansas 67209. Copies of this form are available from the Conservation Division, State Corporation Commission, 3830 So. Meridian (P.O. Box 17027), Wichita, Kansas 66217. Phone AC 316-522-2206. If confidential custody is desired, please note Rule 82-2-125. Drillers Logs will be on an open file in the Oil and Gas Division, State Geological Survey of Kansas, Lawrence, Kansas 66044.

RECEIVED  
 STATE CORPORATION COMMISSION  
 MAR - 8 1979  
 CONSERVATION DIVISION  
 Wichita, Kansas

Operator Anadarko Production Company		DESIGNATE TYPE OF COMP.: OIL, GAS, DRY HOLE, SWDW, ETC.:
Well No. 2	Lease Name PITMAN "A"	Dry Hole
S <u>22</u> T <u>33SR</u> <u>34</u> <sup>XK</sup> <sub>W</sub>		


**WELL LOG**

Show all important zones of porosity and contents thereof; cored intervals, and all drill-stem tests, including depth interval tested, cushion used, time tool open, flowing and shut-in pressures, and recoveries.

SHOW GEOLOGICAL MARKERS, LOGS RUN, OR OTHER DESCRIPTIVE INFORMATION.

FORMATION DESCRIPTION, CONTENTS, ETC.	TOP	BOTTOM	NAME	DEPTH
Redbed	0'	1668'		
Redbed, Shale & Lime	1668'	2393'		
Lime & Shale	2393'	6425'		
DST #1 6112-6276 30-60-60-210, rec 320 drlg mud, IFP 301-308, ISIP 1492, FFP 321-368, FSIP 1628, HP 3238-2957.				
DST #2 4870-4910 30-60-60-120, rec 610 drlg mud, 320 wtr, IFP 374-374, ISIP 1526, FFP 379-483, FSIP 1524, HP 2478-2582.				

USE ADDITIONAL SHEETS, IF NECESSARY, TO COMPLETE WELL RECORD.

Date Received	 Paul Campbell Division Production Manager
	Title _____
	Date March 5, 1979 _____