

STATE OF KANSAS
STATE CORPORATION COMMISSION

WELL PLUGGING RECORD

Give All Information Completely
Make Required Affidavit
Mail or Deliver Report to:
Conservation Division
State Corporation Commission
211 No. Broadway
Wichita, Kansas

Meade

County. Sec. 4 Twp. 33S Rge. (E) 30 (W)

Location as "NE/CNW/SW" or footage from lines NE NE NE

Lease Owner Sunray Mid-Continent Oil Company

Lease Name E. L. Richardson Well No. 1

Office Address 321 West Douglas - Wichita 2, Kansas

Character of Well (completed as Oil, Gas or Dry Hole) Gas

Date well completed August 9 19 55

Application for plugging filed January 18 19 61

Application for plugging approved January 20 19 61


Plugging commenced January 12 19 61

Plugging completed January 14 19 61

Reason for abandonment of well or producing formation Depleted

If a producing well is abandoned, date of last production October 23 19 60

Was permission obtained from the Conservation Division or its agents before plugging was commenced? Yes

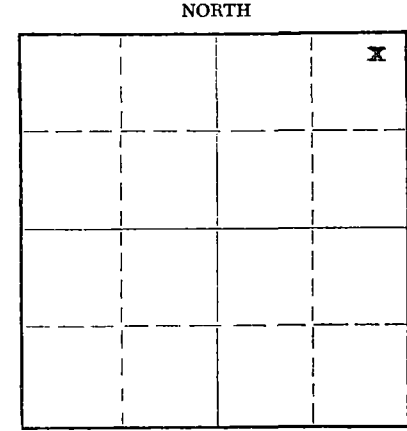

Locate well correctly on above Section Plat

Name of Conservation Agent who supervised plugging of this well W. L. Lackamp

Producing formation Morrow Depth to top 5604 Bottom 5645 Total Depth of Well 5690 Feet

Show depth and thickness of all water, oil and gas formations.

OIL, GAS OR WATER RECORDS

CASING RECORD

FORMATION	CONTENT	FROM	TO	SIZE	PUT IN	PULLED OUT
Morrow	Gas	5604	5645	8-5/8"	2681'	112'
Mississippi	Gas	5646	T.D.	5-1/2"	5686'	4405'

Describe in detail the manner in which the well was plugged, indicating where the mud fluid was placed and the method or methods used in introducing it into the hole. If cement or other plugs were used, state the character of same and depth placed, from _____ feet to _____ feet for each plug set.

Filled hole with sand to 5615' and placed 5 sacks cement plug from 5615-5675'.
Filled with mud from 5575' to 600'. Placed 30 sack cement plug from 600' to 510'.
Filled with mud from 510' to 17'. Placed 10 sack cement plug from 17' to surface.

RECEIVED
STATE CORPORATION COMMISSION
JAN 25 1961
CONSERVATION DIVISION
Wichita Kansas

(If additional description is necessary, use BACK of this sheet)

Name of Plugging Contractor Toland and Reeves
Address Oklahoma City, Oklahoma

STATE OF Kansas, COUNTY OF Sedgwick, ss.
Nash A. Gough (employee of owner) or (owner or operator) of the above-described well, being first duly sworn on oath, says: That I have knowledge of the facts, statements, and matters herein contained and the log of the above-described well as filed and that the same are true and correct. So help me God.

(Signature) Nash A. Gough
321 West Douglas (Address)

SUBSCRIBED AND SWORN TO before me this 24th day of January, 19 61

My commission expires July 13, 1963
N. E. Montgomery Notary Public.



Sunray Mid-Continent Oil Company
Tulsa, Oklahoma

Tulsa, Oklahoma
August 3, 1955

CONTRACTOR: Stickle Drilling Company
Drilling Commenced: June 29, 1955
Drilling Completed: July 31, 1955

Edw. L. Richardson #1 W/2
Sec. 4-338-30W, Meade
County, Kansas.

DRILLERS LOG

Surface Clay	0-20
Shale & Sand	20-400
Shale	400-639
Red Bed	639-1340
Shale & Salt	1340-1545
Shale & Shells	1545-2115
Shale & Lime	2115-2250
Shale & Salt	2250-2400
Salt & Shells	2400-2494
Shale & Lime	2494-2695
Lime	2695-2733
Lime & Shale	2733-2895
Lime	2895-2935
Lime & Shale	2935-2970
Lime	2970-3150
Shale & Lime	3150-3265
Lime & Shale	3265-3365
Shale & Lime	3365-3512
Lime & Shale	3512-3723
Sand	3723-3790
Lime & Shale	3790-3865
Lime	3865-4045
Shale & Lime Streaks	4045-4075
Lime	4075-4103
Shale & Lime	4103-4185
Shale	4185-4275
Shale & Lime	4275-4440
Lime	4440-4520
Chert & Lime	4520-4540
Lime	4540-4668
Lime & Shale	4668-4777
Lime	4777-4915
Lime & Shale	4915-4969
Lime	4969-5283
Lime & Shale	5283-5386
Shale	5386-5429
Lime & Shale	5429-5540
Lime	5540-5570
Lime & Shale	5570-5612
Sand	5612-5650
Mississippi	5650-5690 TD

RECEIVED
STATE CONSERVATION COMMISSION

JAN 25 1961

CONSERVATION DIVISION
Wichita, Kansas

I, Frank E. Stickle hereby certify the above to be a true and complete Drillers Log of Sunray Mid-Continent Oil Company's Edw. L. Richardson #1 W/2 Section 4-338-30W, Meade County, Kansas

Lillian T. Bonham

Notary Public

February 13, 1956

My Commission Expires

Frank E. Stickle

Frank E. Stickle