


STATE OF KANSAS
STATE CORPORATION COMMISSION

Give All Information Completely
Make Required Affidavit
Mail or Deliver Report to:
Conservation Division
State Corporation Commission
212 North Market, Insurance Bldg.
Wichita, Kansas

WELL PLUGGING RECORD

Meade County, Sec. 5 Twp. 33S Rge. (X) 30 (W)
Location as "NE/CNW/SW" or footage from lines NE NE NE
Lease Owner Diamond Shamrock Corporation
Lease Name Pauline V. Hulburt Well No. 1
Office Address Box 631
Character of Well (completed as Oil, Gas or Dry Hole) Gas
Date well completed 6-11 19 57
Application for plugging filed 11-16 19 72
Application for plugging approved 11-20 19 72
Plugging commenced 12-1 19 72
Plugging completed 12-4 19 72
Reason for abandonment of well or producing formation No longer capable of commercial production
If a producing well is abandoned, date of last production November 19 71
Was permission obtained from the Conservation Division or its agents before plugging was commenced? Yes

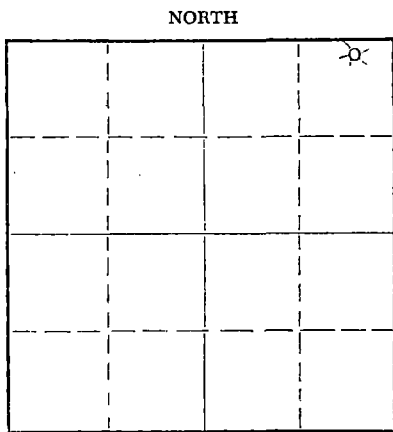

Locate well correctly on above Section Plat

Name of Conservation Agent who supervised plugging of this well Mr. E. Eves
Producing formation Morrow Depth to top 5581 Bottom 5597 Total Depth of Well 5648 Feet
Show depth and thickness of all water, oil and gas formations.

OIL, GAS OR WATER RECORDS

CASING RECORD

FORMATION	CONTENT	FROM	TO	SIZE	PUT IN	PULLED OUT
Morrow	Gas	5581	5597	9 5/8"	2676.51'	
				7"	5647.37'	3,253'

Describe in detail the manner in which the well was plugged, indicating where the mud fluid was placed and the method or methods used in introducing it into the hole. If cement or other plugs were used, state the character of same and depth placed, from _____ feet to _____ feet for each plug set.
Spotted 25 sacks of cement from 5,350' to 5,581'. Shot and pulled 3,253' of 7" casing.
Loaded hole with mud to 900'. Pumped 40 sacks of cement from 800' to 900'. Filled with mud to 45'. Pumped 15 sacks cement from 0' to 45'.

RECEIVED
STATE CORPORATION COMMISSION
DEC 7 - 1972
CONSERVATION DIVISION
Wichita, Kansas

(If additional description is necessary, use BACK of this sheet)
Name of Plugging Contractor Sargent Casing Pulling
Address Box 506, Liberal, Kansas 67901

STATE OF Texas, COUNTY OF Potter, ss.
Joe P Rowell (employee of owner) or (owner or operator) of the above-described well, being first duly sworn on oath, says: That I have knowledge of the facts, statements, and matters herein contained and the log of the above-described well as filed and that the same are true and correct. So help me God.

(Signature) Joe P Rowell
Box 631, Amarillo, Texas (Address)

SUBSCRIBED AND SWORN to before me this 5th day of December, 1972

My commission expires 6-1-73

PAULINE POWERS
Notary Public
Potter County, Texas
Notary Public.



HULBURT #1

330' S of N Line & 330' W of E Line of Section 5-33S-30W

Rigged up Rotary Tools 3/26/57 Ran 87 Jts. (2680.77) 9-5/8" 32# surface pipe set @ 2676.51'. Cemented w/350 sacks Posmix, 100 sacks common first stage; second stage 450 sacks common.

Tore down Rotary Tools 5/10/57 Ran 40 Jts. (1322.48') and 124 Jts. (4300.25') 23# J-55 & landed w/one Jt. (32.39') 23#. Total (5655.12') set @ 5647.37'.

<u>FORMATION</u>	<u>FROM</u>	<u>TC</u>
Sand & Dirt	0'	70'
Sand	70	225
Sand, shells & shale	225	825
Shells & redbed	825	1,030
Sand & shale	1,030	1,185
Sand, shale & shells	1,185	1,545
Shale, anhydrite & shells	1,545	1,820
Shale & shells	1,820	2,125
Lime	2,125	2,200
Shale & lime streaks	2,200	2,505
Lime	2,505	2,772
Shale & lime	2,772	4,143
Lime	4,143	4,171
Lime & shale	4,171	4,510
Lime & chert	4,510	4,558
Lime	4,558	4,635
Lime w/shale streaks	4,635	4,716
Lime	4,716	4,922
Lime w/shale	4,922	5,435
Lime	5,435	5,450
Lime & shale	5,450	5,569
Sand & shale	5,569	5,596
Sand & shale streaks	5,596	5,648 T.D.

RECEIVED
STATE CORPORATION COMMISSION
JULY - 1957
CONSERVATION DIVISION
Wichita, Kansas

I, Don S. Packer, do hereby certify that the foregoing log is true and correct, to the best of my knowledge and belief.

Subscribed and sworn to before me this 15th day of May, 1957.

My Commission expires: July 29, 1957