


STATE OF KANSAS
STATE CORPORATION COMMISSION
Give All Information Completely
Make Required Affidavit
Mail or Deliver Report to:
Conservation Division
State Corporation Commission
800 Bitting Building
Wichita, Kansas

WELL PLUGGING RECORD

Meade County, Sec. 7 Twp. 33 Rge. 30 (E) (W)
Location as "NE/CNW/SW" or footage from lines 1,390' fr. N, 1,390' fr. E.
Lease Owner The Shamrock Oil and Gas Corporation
Lease Name Collingwood "A" Well No. 1
Office Address Box 631, Amarillo, Texas
Character of Well (completed as Oil, Gas or Dry Hole) Dry Hole
Date well completed September 19, 19 55
Application for plugging filed September 19, 19 55
Application for plugging approved September 19, 19 55
Plugging commenced September 19, 19 55
Plugging completed September 19, 19 55
Reason for abandonment of well or producing formation Dry Hole

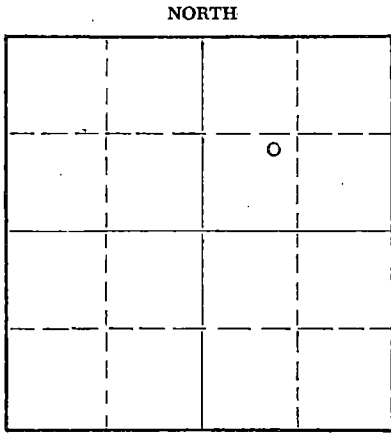

Locate well correctly on above Section Plat

If a producing well is abandoned, date of last production 19
Was permission obtained from the Conservation Division or its agents before plugging was commenced? Yes

Name of Conservation Agent who supervised plugging of this well Merle Rives
Producing formation None Depth to top --- Bottom --- Total Depth of Well 5704 Feet
Show depth and thickness of all water, oil and gas formations.

OIL, GAS OR WATER RECORDS

CASING RECORD

FORMATION	CONTENT	FROM	TO	SIZE	PUT IN	PULLED OUT
Sand and red beds	Water	0	650	13 3/8"	OD 800	None
Red bed and shale	---	---	---	9 5/8"	OD 2,636	None

Describe in detail the manner in which the well was plugged, indicating where the mud fluid was placed and the method or methods used in introducing it into the hole. If cement or other plugs were used, state the character of same and depth placed, from _____ feet to _____ feet for each plug set.
Plugged back hole from 5,704' to 650' with heavy mud. Pushed 9 5/8" Halliburton plug down casing to 650'. Spotted 35 sacks cement on top of plug from 650' to 574'. Spotted heavy mud from 574' to 35'. Pushed 9 5/8" Halliburton plug down casing to 35'. Spotted 15 sacks cement from 35' to surface.

RECEIVED
STATE CORPORATION COMMISSION
SEP 21 1955
CONSERVATION DIVISION
Wichita, Kansas

(If additional description is necessary, use BACK of this sheet)
Name of Plugging Contractor Halliburton Oil Well Cementing Company
Address Great Bend, Kansas

STATE OF TEXAS, COUNTY OF POTTER, ss.
Dan P. Long (employee of owner) or (owner/operator) of the above-described well, being first duly sworn on oath, says: That I have knowledge of the facts, statements, and matters herein contained and the log of the above-described well as filed and that the same are true and correct. So help me God.

(Signature) Dan P. Long
Box 631, Amarillo, Texas (Address)

SUBSCRIBED AND SWORN TO before me this 20th day of September, 19 55

My commission expires _____

PAULINE POWELL
Notary Public
Potter County, Texas.

PLUGGING
FILE SEC 7 T 33 R 30 W
BOOK PAGE 2 LINE 7

Sec 7-33-30W

LOG OF
THE SHAMROCK OIL AND GAS CORPORATION
COLLINGWOOD "A" NO. 1
MEADE COUNTY, KANSAS

0'	-	770'	Sand and shale
770'	-	812'	Red Beds
812'	-	1,970'	Shale, gyp, and red beds
1,970'	-	2,525'	Anhydrite and shale
2,524'	-	2,621'	Anhydrite
2,621'	-	3,260'	Dolomite and lime
3,260'	-	3,823'	Lime
3,823'	-	5,704'	Lime and shale

RECEIVED
STATE COMMISSION
SET 2 1955
CONSERVATION DIVISION
Wichita, Kansas

PLUGGING
FILE SEC 7 T 33 R 30W
BOOK PAGE 2 LINE 7