

DEC 20 1965

Form CP-4

STATE OF KANSAS
STATE CORPORATION COMMISSION

Give All Information Completely
Make Required Affidavit
Mail or Deliver Report to:
Conservation Division
State Corporation Commission
211 No. Broadway
Wichita, Kansas

WELL PLUGGING RECORD

Meade County, Sec. 9 Twp. 33S Rge. 30 (S) (W)

Location as "NE/CNW/SW" or footage from lines C of NW - SW

Lease Owner Shenandoah Oil Corporation

Lease Name George W. Butler Well No. 1

Office Address 406 Mutual Savings Bldg., Fort Worth, Texas

Character of Well (completed as Oil, Gas or Dry Hole) Dry Hole

Date well completed December 12, 1965

Application for plugging filed December 16, 1965

Application for plugging approved Verbal approval received 12-12-1965


Plugging commenced December 12, 1965

Plugging completed 4:30 P.M. December 12, 1965

Reason for abandonment of well or producing formation Dry Hole

If a producing well is abandoned, date of last production 19

Was permission obtained from the Conservation Division or its agents before plugging was commenced? Yes

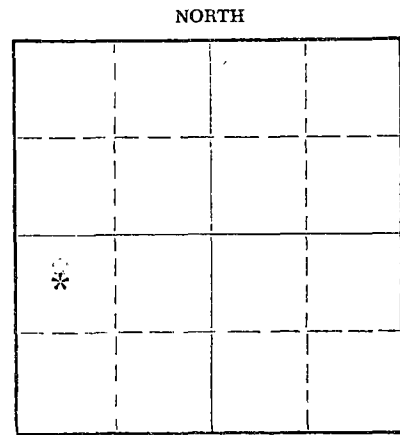

Locate well correctly on above Section Plat

Name of Conservation Agent who supervised plugging of this well Mr. Hugh Scott, Sublette, Kansas

Producing formation None Depth to top Bottom Total Depth of Well 6183 Feet

Show depth and thickness of all water, oil and gas formations.

OIL, GAS OR WATER RECORDS

CASING RECORD

FORMATION	CONTENT	FROM	TO	SIZE	PUT IN	PULLED OUT
None				8-5/8"	1626'	None

Describe in detail the manner in which the well was plugged, indicating where the mud fluid was placed and the method or methods used in introducing it into the hole. If cement or other plugs were used, state the character of same and depth placed, from feet to feet for each plug set.

Hole filled with heavy mud. Spotted 35 sack cement plug from 600'-700', 15 sack cement plug from 0'-45'. Cut off 8-5/8" casing 3' below ground level and welded on steel cap.

(If additional description is necessary, use BACK of this sheet)

Name of Plugging Contractor Lohman-Johnson Drilling Company
Address Wichita, Kansas

STATE OF Texas, COUNTY OF Tarrant, ss.

Harold E. Burke (employee of owner) or (owner or operator) of the above-described well, being first duly sworn on oath, says: That I have knowledge of the facts, statements, and matters herein contained and the log of the above-described well as filed and that the same are true and correct. So help me God.

(Signature) Harold E. Burke

406 Mutual Savings Bldg., Ft. Worth, Tex. (Address)

SUBSCRIBED AND SWORN to before me this 17th day of December, 1965

My commission expires June 1, 1967

Mary D. Semmler Notary Public.