


STATE OF KANSAS  
STATE CORPORATION COMMISSION

Give All Information Completely  
Make Required Affidavit  
Mail or Deliver Report to:  
Conservation Division  
State Corporation Commission  
212 North Market, Insurance Bldg.  
Wichita, Kansas

WELL PLUGGING RECORD

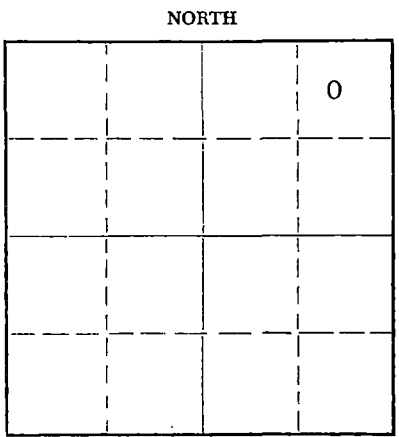

Locate well correctly on above  
Section Plat

Meade County. Sec. 10 Twp. 33S Rge. 30 (E) W (W)  
Location as "NE/CNW/SW" or footage from lines 660' fr N&E Ls, C NE NE  
Lease Owner Petroleum Exploration, Inc.  
Lease Name Leslie "A" Well No. 1-10  
Office Address Box 2009, Amarillo, Texas  
Character of Well (completed as Oil, Gas or Dry Hole) oil  
Date well completed 5-19- 19 60  
Application for plugging filed 11-1- 19 61  
Application for plugging approved 11-8- 19 61  
Plugging commenced 11-8- 19 61  
Plugging completed 11-10- 19 61  
Reason for abandonment of well or producing formation production dropped below  
economic limit  
If a producing well is abandoned, date of last production 11-4 - 19 61  
Was permission obtained from the Conservation Division or its agents before plugging was com-  
menced? yes

Name of Conservation Agent who supervised plugging of this well Bill Lakamp, Stafford, Kansas  
Producing formation Morrow Depth to top 5726 Bottom 5748 Total Depth of Well 5785 Feet  
Show depth and thickness of all water, oil and gas formations.

OIL, GAS OR WATER RECORDS

CASING RECORD

FORMATION	CONTENT	FROM	TD	SIZE	PUT IN	PULLED OUT
Morrow	Oil-Gas	5726	5748	8-5/8"	1520	none
				4-1/2"	5774	2691

Describe in detail the manner in which the well was plugged, indicating where the mud fluid was placed and the method or methods used in introducing it into the hole. If cement or other plugs were used, state the character of same and depth placed, from \_\_\_\_\_ feet to \_\_\_\_\_ feet for each plug set.  
Pumped 15 sacks cement in front of Halliburton plug - TD to 5500. Shot pipe at 2691, spotted 10 sacks, cement plug from 1530 to 1500, 15 sacks cement from 600-555, spotted 10 sacks from 30' down to within 3 ft. of GL.  
Place mud laden fluid between each cement plug.

RECEIVED  
STATE CORPORATION COMMISSION  
NOV 14 1961  
CONSERVATION DIVISION  
Wichita, Kansas

(If additional description is necessary, use BACK of this sheet)  
Name of Plugging Contractor Daco Well Service, Borger, Texas  
Address Borger, Texas

STATE OF Texas, COUNTY OF Potter, ss.  
J. L. Farrell (employee of owner) or (owner or operator) of the above-described well, being first duly sworn on oath, says: That I have knowledge of the facts, statements, and matters herein contained and the log of the above-described well as filed and that the same are true and correct. So help me God.

(Signature) *J. L. Farrell*  
Box 2009, Amarillo, Texas (Address)

SUBSCRIBED AND SWORN TO before me this 13th day of November, 19 61

My commission expires June 1963 *Trip Lee Shife* Notary Public.

