


STATE OF KANSAS
STATE CORPORATION COMMISSION

Give All Information Completely
Make Required Affidavit
Mail or Deliver Report to:
Conservation Division
State Corporation Commission
212 North Market, Insurance Bldg.
Wichita, Kansas

WELL PLUGGING RECORD

NORTH

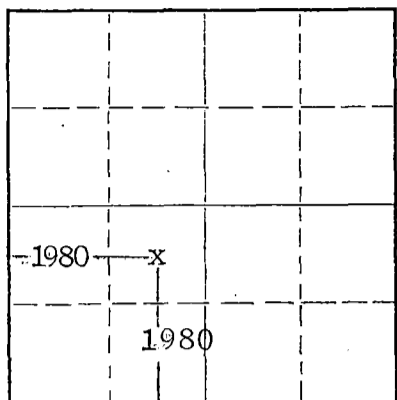

Locate well correctly on above
Section Plat

Meade County, Sec. 11 Twp. 33 Rge. 30 (E) (W)
Location as "NE/CNW&SW&" or footage from lines NE SE W
Lease Owner Petroleum Exploration, Inc.
Lease Name Leslie Well No. A-1-11
Office Address Box 1628 Amarillo, Texas
Character of Well (completed as Oil, Gas or Dry Hole) dry hole
Date well completed 7-4-60 19
Application for plugging filed yes 19
Application for plugging approved yes 19
Plugging commenced 7-18-60 19
Plugging completed 7-25-60 19
Reason for abandonment of well or producing formation dry hole

If a producing well is abandoned, date of last production 19
Was permission obtained from the Conservation Division or its agents before plugging was commenced? yes

Name of Conservation Agent who supervised plugging of this well Bill Lac Kamp
Producing formation Morrow Depth to top 5793 Bottom 5815 Total Depth of Well 5880 Feet
Show depth and thickness of all water, oil and gas formations.

OIL, GAS OR WATER RECORDS

CASING RECORD

FORMATION	CONTENT	FRDM	TD	SIZE	PUT IN	PULLED OUT
Morrow	dry	5793	5815	4 1/2"		2537'
				8-5/8"	1508	0'

Describe in detail the manner in which the well was plugged, indicating where the mud fluid was placed and the method or methods used in introducing it into the hole. If cement or other plugs were used, state the character of same and depth placed, from _____ feet to _____ feet for each plug set.

Plugging commenced 7-18-60. Plugging completed 7-25-60. Measured into total depth, 5880'. Plugged off bottom with 10 gal. rock and 5 sacks of cement. Worked and shot casing. Shot 4 1/2" casing free at 2537'. Built rack and slide. Pulled and laid down casing. Plugged hole. Mudded up to 500'. Set 10' rock bridge. Dumped 15 sacks of cement. Mudded hole up to 40'. Set 10' rock bridge. Capped the well with 10 sacks of cement.

RECEIVED
STATE CORPORATION COMMISSION

AUG 4 1960

CONSERVATION DIVISION
Wichita, Kansas

(If additional description is necessary, use BACK of this sheet)

Name of Plugging Contractor J. O. Forbes d/b/a Forbes Casing Pulling
Address Box 221 Great Bend, Kansas

STATE OF Kansas, COUNTY OF Barton, ss.
J. O. Forbes (employee of owner) or (owner or operator) of the above-described well, being first duly sworn on oath, says: That I have knowledge of the facts, statements, and matters herein contained and the log of the above-described well as filed and that the same are true and correct. So help me God.

(Signature) J. O. Forbes
Box 221 Great Bend, Kansas
(Address)

SUBSCRIBED AND SWORN TO before me this 26th day of July, 1960

My commission expires December 8th, 1963

Kayann Jenkins
Kayann Jenkins Notary Public.

