


Give All Information Completely  
Make Required Affidavit  
Mail or Deliver Report to:  
Conservation Division  
State Corporation Commission  
211 No. Broadway  
Wichita, Kansas

WELL PLUGGING RECORD

NORTH

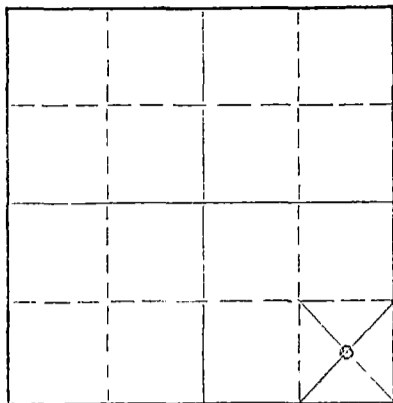

Locate well correctly on above  
Section Plat

Seward County. Sec. 8 Twp. 33S Rge. (E) 32 (W)  
Location as "NE/CNW/SW" or footage from lines C SE/4 SE/4  
Lease Owner Whitehall Oil Company  
Lease Name E. E. Hirn Well No. 1  
Office Address 900 Vaughn Building, Dallas 1, Texas  
Character of Well (completed as Oil, Gas or Dry Hole) Dry Hole  
Date well completed P & A September 18 1962  
Application for plugging filed September 18 1962  
Application for plugging approved September 18 1962  
Plugging commenced 10:00 a.m. September 18 1962  
Plugging completed 11:00 a.m. September 18 1962  
Reason for abandonment of well or producing formation No prospective pay zones  
If a producing well is abandoned, date of last production - - - - - 19  
Was permission obtained from the Conservation Division or its agents before plugging was commenced? Yes

Name of Conservation Agent who supervised plugging of this well Hugh Scott  
Producing formation - - - - - Depth to top - - - - - Bottom - - - - - Total Depth of Well 6400 Feet  
Show depth and thickness of all water, oil and gas formations.

OIL, GAS OR WATER RECORDS

CASING RECORD

FORMATION	CONTENT	FROM	TO	SIZE	PUT IN	PULLED OUT
				8-5/8"	2280'	0

Describe in detail the manner in which the well was plugged, indicating where the mud fluid was placed and the method or methods used in introducing it into the hole. If cement or other plugs were used, state the character of same and depth placed, from \_\_\_\_\_ feet to \_\_\_\_\_ feet for each plug set.

Cement was pumped in hole through the drill pipe and one 30-sack plug was placed from 700' to 608', and a second plug of 20 sacks was placed from 45' to the surface of the ground. The remainder of the hole was filled with 9.1#/gallon drilling mud.

RECEIVED  
STATE CORPORATION COMMISSION  
SEP 20 1962  
9-20-62  
CONSERVATION DIVISION  
Wichita, Kansas

(If additional description is necessary, use BACK of this sheet)

Name of Plugging Contractor Halliburton Company  
Address P. O. Drawer 1431, Duncan, Oklahoma

STATE OF TEXAS, COUNTY OF DALLAS, ss.  
Dale O. Chase (employee of owner) or (~~XXXXXXXXXX~~) of the above-described

well, being first duly sworn on oath, says: That I have knowledge of the facts, statements, and matters herein contained and the log of the above-described well as filed and that the same are true and correct. So help me God.

(Signature) Dale O. Chase  
900 Vaughn Bldg., Dallas 1, Texas  
(Address)

SUBSCRIBED AND SWORN TO before me this 19th day of September, 19 62

Emmale Coody  
Notary Public.

My commission expires June 1, 1963

