

15-175-10029-00-00

STATE OF KANSAS  
STATE CORPORATION COMMISSION

WELL PLUGGING RECORD

Give All Information Completely  
Make Required Affidavit  
Mail or Deliver Report to:  
Conservation Division  
State Corporation Commission  
211 No. Broadway  
Wichita, Kansas

Seward County, Sec. 20 Twp. 33S Rge. 7E 32(W)

Location as "NE/CNW/SW" or footage from lines C NE/4 SW/4

Lease Owner Cities Service Oil Company

Lease Name Salley "E" Well No. 1

Office Address Box 6 Liberal, Kansas

Character of Well (completed as Oil, Gas or Dry Hole) Dry Hole

Date well completed 9-28-1963

Application for plugging filed 19

Application for plugging approved 19


Plugging commenced 9-27-1963

Plugging completed 9-28-1963

Reason for abandonment of well or producing formation

If a producing well is abandoned, date of last production 19

Was permission obtained from the Conservation Division or its agents before plugging was commenced? Yes

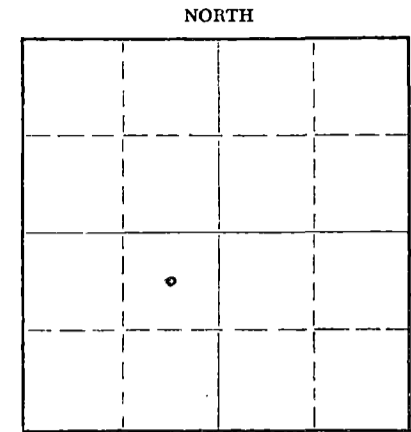

Locate well correctly on above Section Plat

Name of Conservation Agent who supervised plugging of this well Hugh Scott

Producing formation Depth to top Bottom Total Depth of Well 6292 Feet

Show depth and thickness of all water, oil and gas formations.

OIL, GAS OR WATER RECORDS

CASING RECORD

FORMATION	CONTENT	FROM	TO	SIZE	PUT IN	PULLED OUT
Hugoton	Possible gas or water	2470	2720	8 5/8"	1425	None

Describe in detail the manner in which the well was plugged, indicating where the mud fluid was placed and the method or methods used in introducing it into the hole. If cement or other plugs were used, state the character of same and depth placed, from feet to feet for each plug set.

- 6292'-2750' Mud
- 2750'-2669' 25 sx cement - Halliburton
- 2669'-2450' Mud
- 2450'-2369' 25 sx cement - Halliburton
- 2369'- 700' Mud
- 700'- 592' 35 sx cement - Halliburton
- 592'- 40' Mud
- 40'- 0 15 sx cement - Dumped

RECEIVED  
STATE CORPORATION COMMISSION  
OCT 7 1963  
10-7-63  
CONSERVATION DIVISION  
Wichita, Kansas

(If additional description is necessary, use BACK of this sheet)

Name of Plugging Contractor Halliburton Company

Address Duncan, Oklahoma

STATE OF KANSAS, COUNTY OF SEWARD, ss.

W. J. Devaney (employee of owner) or (owner or operator) of the above-described well, being first duly sworn on oath, says: That I have knowledge of the facts, statements, and matters herein contained and the log of the above-described well as filed and that the same are true and correct. So help me God.

(Signature) W. J. Devaney  
Box 6 Liberal, Kansas  
(Address)

SUBSCRIBED AND SWORN TO before me this 30th day of September, 1963

My commission expires 11-5-66

Calvin Lindsey  
Calvin Lindsey Notary Public.



ROTARY DRILLING LOG

OWNER: Cities Service Oil Company CASING: Set 8 5/8" 24# J-55 casing  
 CONTRACTOR: Lohmann-Johnson Drilling Co. @ 1424', cemented with 625  
 LEASE: Salley "E" #1 sx common cement  
 LOCATION: C NE SW Sec. 20-33S-32W  
 Seward County, Kansas

0 - 800	Anhydrite
800 - 1410	Red Shale
1410 - 1425	Anhydrite
1425 - 1713	Shale
1713 - 2147	Sand & Shale
2147 - 2556	Shale
2556 - 2677	Lime & Shale
2677 - 2807	Sand, Limestone & Shale
2807 - 3100	Lime
3100 - 3220	Shale & Lime
3220 - 3450	Lime & Shale
3450 - 3821	Lime
3821 - 3985	Lime & Shale
3985 - 4154	Shale & Lime
4154 - 4225	Lime & Shale
4225 - 4313	Lime
4313 - 4397	Lime & Shale
4397 - 5395	Lime
5395 - 5627	Lime & Shale
5627 - 5652	Lime
5652 - 5705	Lime & Shale
5705 - 5755	Lime
5755 - 5850	Lime & Shale
5850 - 6292	Lime
6292	Rotary Total Depth

D & A

**RECEIVED**  
 STATE CORPORATION COMMISSION

OCT 22 1963

CONSERVATION DIVISION  
 Wichita, Kansas

We certify that the above log is true and correct to the best of our knowledge and belief.

CITIES SERVICE OIL COMPANY

BY *W. J. Devaney*  
 W. J. Devaney  
 District Superintendent