

15-175-00224-00-60

Form CP-4


STATE OF KANSAS  
STATE CORPORATION COMMISSION

Give All Information Completely  
Make Required Affidavit  
Mail or Deliver Report to:  
Conservation Division  
State Corporation Commission  
211 No. Broadway  
Wichita, Kansas

WELL PLUGGING RECORD

Seward County. Sec. 21 Twp. 33S Rge. (E) 32 (W)  
Location as "NE/CNW/SW" or footage from lines C SW/4  
Lease Owner Graham-Michaelis Drilling, Inc.  
Lease Name Salley Well No. 1-21  
Office Address 211 North Broadway, Wichita, Kansas 67202  
Character of Well (completed as Oil, Gas or Dry Hole) Dry Hole  
Date well completed July 6, 1966 19\_\_  
Application for plugging filed July 6, 19\_\_66  
Application for plugging approved (verbal) July 6, 19\_\_66  
Plugging commenced July 6, 19\_\_66  
Plugging completed July 6, 19\_\_66  
Reason for abandonment of well or producing formation \_\_\_\_\_

NORTH

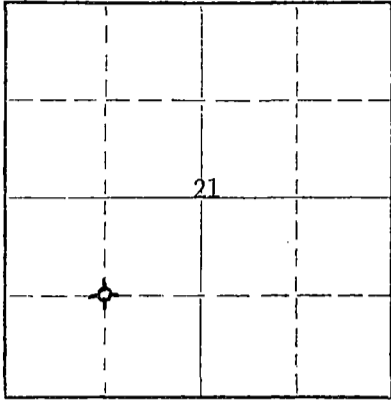

Locate well correctly on above  
Section Plat

If a producing well is abandoned, date of last production \_\_\_\_\_ 19\_\_  
Was permission obtained from the Conservation Division or its agents before plugging was commenced? yes

Name of Conservation Agent who supervised plugging of this well Edgar J. Eves, Sublette (for Seward Co.)  
Producing formation none Depth to top \_\_\_\_\_ Bottom \_\_\_\_\_ Total Depth of Well 5900 Feet  
Show depth and thickness of all water, oil and gas formations.

OIL, GAS OR WATER RECORDS

CASING RECORD

FORMATION	CONTENT	FROM	TO	SIZE	PUT IN	PULLED OUT
				8 5/8"	1361'	none

Describe in detail the manner in which the well was plugged, indicating where the mud fluid was placed and the method or methods used in introducing it into the hole. If cement or other plugs were used, state the character of same and depth placed, from \_\_\_\_\_ feet to \_\_\_\_\_ feet for each plug set.  
35 sx cement between 600 and 700', 15 sax cement at 45', cement plug at top of surface casing.

RECEIVED  
STATE CORPORATION COMMISSION  
JUL 14 1966  
7-14-66

(If additional description is necessary, use BACK of this sheet)  
Name of Plugging Contractor Graham-Michaelis Drilling, Inc.  
Address 211 North Broadway, Wichita, Kansas 67202

STATE OF Kansas, COUNTY OF Sedgwick, ss.  
Jack L. Yinger (employee of owner) or (~~owner~~) of the above-described well, being first duly sworn on oath, says: That I have knowledge of the facts, statements, and matters herein contained and the log of the above-described well as filed and that the same are true and correct. So help me God.

(Signature) Jack L. Yinger Geologist  
211 North Broadway, Wichita, Kansas 67202  
(Address)

SUBSCRIBED AND SWORN TO before me this 6th day of July, 1966

My commission expires December 12, 1966  
Evelyn D. Evans Notary Public.

15-175-0022400-00

SALLEY NO. 1-21

WELL RECORD:

LOCATION:

C SW/4 Section 21-33S-32W  
Seward County, Kansas

Commenced: 6-23-66  
Completed: 7-7-66  
(Rotary)

CONTRACTOR:

Graham-Michaelis Drilling, Inc.  
Liberal Division  
P. O. Box 1294  
Liberal, Kansas 67901

CASING RECORD:

42 Joints 8-5/8" 24# Casing  
Cemented w/600 sx Lt. Wt. 2% cc  
followed w/200 sx Sunset

LOG

Red Bed	0 - 766
Sand, Red Bed & Anhy	766 - 1362
Anhy & Shale	1362 - 1927
Lime & Shale	1927 - 4464
Lime	4464 - 5422
Lime & Shale	5422 - 5665
Lime	5665 - 5900

RECEIVED  
STATE CORPORATION COMMISSION

JUL 14 1966

LIBERAL DIVISION  
WICHITA, KANSAS

5900' - Total Rotary Depth

The undersigned, Graham-Michaelis Drilling, Inc., Liberal Division, certifies that the above log is a true and correct copy of the formations encountered in drilling the above mentioned well, as taken from the Daily Drilling Report.

GRAHAM-MICHAELIS DRILLING, INC.  
LIBERAL DIVISION

By H. R. Michaelis  
H. R. Michaelis

HRM/rw