

NOV 24 1982

STATE OF KANSAS STATE CORPORATION COMMISSION

WELL PLUGGING RECORD

Give All Information Completely Make Required Affidavit Mail or Deliver Report to Conservation Division State Corporation Comm. 245 North Water Wichita, KS 67202

Meade County. Sec. 14 Twp. 33 Rge 30 R/W Location as "NE/CNW 1/4 SW 1/4" or footage from lines C-SE-SW-SW

Lease Owner Deck Oil Company Lease Name Hamm Well No. 4 Office Address Suite 4000, One Williams Center, Tulsa OK 74172 Character of Well (Completed as Oil, Gas or Dry Hole) Dry


Date Well completed 11-18-82 Application for plugging filed 10-11-82 Application for plugging approved 10-14-82 Plugging commenced 11-16-82 Plugging completed 11-18-82

Reason for abandonment of well or producing formation Non Commercial Value

If a producing well is abandoned, date of last production None

Was permission obtained from the Conservation Division or its agents before plugging was commenced? yes

Name of Conservation Agent who supervised plugging of this well Mr. Luthi Producing formation Marmaton Depth to top 5199 Bottom 5202 Total Depth of Well 5250 Show depth and thickness of all water, oil and gas formations.

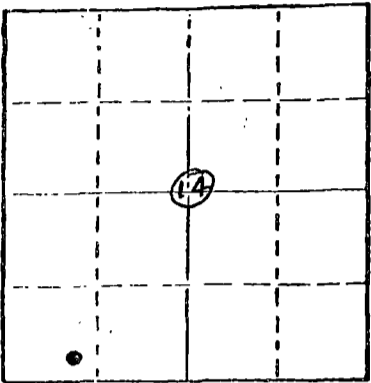

Locate well correctly on above Section Plot

OIL, GAS OR WATER RECORDS

CASING RECORD

Table with 7 columns: FORMATION, CONTENT, FROM, TO, SIZE, PUT IN, PULLED OUT. Rows include Surface (8 5/8" casing, 1608' depth) and Production (4 1/2" casing, 5250' depth, 2820' pulled out).

Describe in detail the manner in which the well was plugged, indicating where the mud fluid was placed and the method or methods used in introducing it into the hold. If cement or other plugs were used, state the character of same and depth placed, from feet to feet for each plug set.

Pumped 1 sk. hulls & 15 sks. cement to 4830' - Pressured to 750 lbs. Layed down 4 1/2" to 1600' Pumped 40 sks. cement 1600' to 1500' Layed down 4 1/2" to 780' Pumped 20 sks. cement 750' to 700' Put bridge & 10 sks. cement 40' to 0' Cut off 8 5/8", 3' below ground level & welded plate on same

(If additional description is necessary, use BACK of this sheet)

Name of Plugging Contractor Midwest Casing Pulling Service Lic. # 6497

STATE OF KANSAS COUNTY OF HASKELL, ss. I, Edgar J. Eves (owner or operator) of the above-described well, being first duly sworn on oath, says: That I have knowledge of the facts, statements, and matters herein contained and the log of the above-described well as filed and that the same are true and correct. So help me God.

(Signature) Edgar J. Eves Box 6, Sublette, Ks. 67877 (Address)

SUBSCRIBED AND SWORN TO before me this 22nd day of Nov., 1982

Sandra L Eves Notary Public.

My commission expires 12-6-84

