

STATE CORPORATION COMMISSION OF KANSAS
OIL & GAS CONSERVATION DIVISION

WELL COMPLETION OR RECOMPLETION FORM
ACO-1 WELL HISTORY

DESCRIPTION OF WELL AND LEASE

Operator: license # 5181
name Donald C. Slawson
address 20 N. Broadway, #700
City/State/Zip Okla. City, OK 73102

Operator Contact Person Steve Slawson
Phone (800) 333-5493

Contractor: license # 5147
name BEREDCO INC.

Wellsite Geologist N/A
Phone

PURCHASER

Designate Type of Completion

New Well Re-Entry Workover

Oil SWD Temp Abd
 Gas Inj Delayed Comp.
 Dry Other (Core, Water Supply etc.)

If OWWO: old well info as follows:

Operator
Well Name
Comp. Date Old Total Depth

WELL HISTORY

Drilling Method: Mud Rotary Air Rotary Cable

2/06/89 2/16/89 2/17/89
Spud Date Date Reached TD Completion Date

6000' N/A
Total Depth PBT
41 jts, 8-5/8", 24#, J-55
Amount of Surface Pipe Set and Cemented at 1598 feet

Multiple Stage Cementing Collar Used? Yes No

If Yes, Show Depth Set feet

If alternate 2 completion, cement circulated
from feet depth to w/ SX cml

ALT I UFA

API NO. 15 - 175-21,070 - 0000
County Seward
Apr N/2 N/2 Sec 6 Twp 33S Rge 33W West
(location)
4620 Ft North from Southeast Corner of Section
3140 Ft West from Southeast Corner of Section
(Note: locate well in section plat below)


Lease Name JERMAN Well# 1-6

Field Name Kansas Hugoton

Producing Formation Dry

Elevation: Ground 2850 KB 2862.5

Section Plat

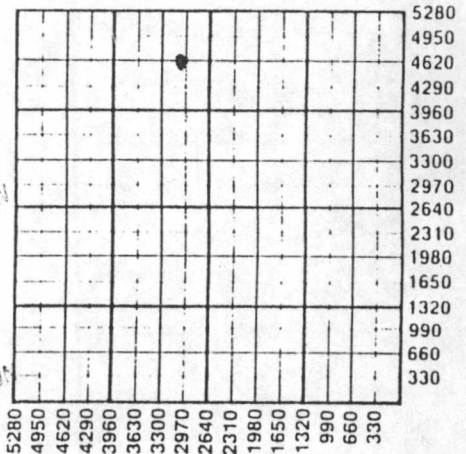

RECEIVED
STATE CORPORATION COMMISSION
OCT 9 1989
CONSERVATION DIVISION
Wichita, Kansas

WATER SUPPLY INFORMATION

Source of Water: Water well #T89-051
Division of Water Resources Permit # N/A

Groundwater Ft North From Southeast Corner and
(Well) Ft West From Southeast Corner of
Sec Twp Rge East West

Surface Water Ft North From Southeast Corner and
(Stream, Pond etc.) Ft West From Southeast Corner
Sec Twp Rge East West

Other (explain)
(purchased from city, R.W.D.#)

Disposition of Produced Water: Disposal Repressuring

Docket #

INSTRUCTIONS: This form shall be completed in duplicate and filed with the Kansas Corporation Commission, 200 Colorado Derby Building, Wichita, Kansas 67202, within 90 days after completion or recompletion of any well. Rules 82-3-130 and 82-3-107 apply.

Information on side two of this form will be held confidential for a period of 12 months if requested in writing and submitted with the form. See rule 82-3-107 for confidentiality in excess of 12 months.

One copy of all wireline logs and drillers time log shall be attached with this form. Submit CP-4 form with all plugged wells. Submit CP-111 form with all temporarily abandoned wells.

All requirements of the statutes, rules, and regulations promulgated to regulate the oil and gas industry have been fully complied with and the statements herein are complete and correct to the best of my knowledge.

Signature Stephen B. Slawson
Title Division Engineer Date 3/7/89

Subscribed and sworn to before me this 8th day of March 1989
Notary Public
Date Commission Expires 1-14-92

K.C.C. OFFICE USE ONLY
 Letter of Confidentiality Attached
 Wireline Log Received
 Drillers Timelog Received
Distribution
 KCC SWD/Rep NGPA
 KGS Plug Other
(Specify)
3-9-89

Sec. 6... Twp 33S... Rge. 33W