

STATE CORPORATION COMMISSION OF KANSAS  
OIL & GAS CONSERVATION DIVISION  
WELL COMPLETION FORM  
ACO-1 WELL HISTORY  
DESCRIPTION OF WELL AND LEASE

Operator: License # 5598  
Name: APX Corporation  
Address P.O. Box 351  
City/State/Zip Liberal, KS 67905-0351  
Purchaser: Panhandle Eastern Pipeline Co.  
(Transporter)  
Operator Contact Person: M. L. Pease  
Phone ( 316 ) 624-6253

Contractor: Name: Gabbert-Jones, Inc.  
License: 5842  
Wellsite Geologist: NA


Designate Type of Completion  
 New Well  Re-Entry  Workover  
 Oil  SWD  Temp. Abd.  
 Gas  Inj  Delayed Comp.  
 Dry  Other (Core, Water Supply, etc.)

If **OWO**: old well info as follows:  
Operator: \_\_\_\_\_  
Well Name: \_\_\_\_\_  
Comp. Date \_\_\_\_\_ Old Total Depth \_\_\_\_\_

Drilling Method:  
 Mud Rotary  Air Rotary  Cable  
9/1/89 9/3/89 12/2/89  
Spud Date Date Reached TD Completion Date

API NO. 15- 175-21,104--0000  
County Seward  
NW SE SE Sec. 31 Twp. 33S Rge. 34  Eas  
1250 Ft. North from Southeast Corner of Section  
1250 Ft. West from Southeast Corner of Section  
(NOTE: Locate well in section plat below.)

Lease Name Barrett "A" Well # 1H  
Field Name Hugoton  
Producing Formation Chase  
Elevation: Ground 2951.3 KB NA  
Total Depth 2885 PBDT 2874

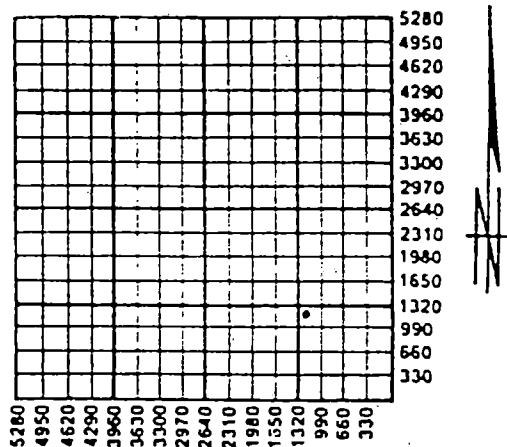

Amount of Surface Pipe Set and Cemented at 706 Feet  
Multiple Stage Cementing Collar Used?  Yes  No  
If yes, show depth set \_\_\_\_\_ Feet  
If Alternate II completion, cement circulated from \_\_\_\_\_  
feet depth to \_\_\_\_\_ w/ \_\_\_\_\_ sx cmt.

**INSTRUCTIONS:** This form shall be completed in triplicate and filed with the Kansas Corporation Commission, 200 Colorado Derby Building, Wichita, Kansas 67202, within 120 days of the spud date of any well. Rule 82-3-130, 82-3-107 and 82-3-106 apply. Information on side two of this form will be held confidential for a period of 12 months if requested in writing and submitted with the form. See rule 82-3-107 for confidentiality in excess of 12 months. One copy of all wireline logs and drillers time log shall be attached with this form. ALL CEMENTING TICKETS MUST BE ATTACHED. Submit CP-4 form with all plugged wells. Submit CP-111 form with all temporarily abandoned wells. Any recompletion, workover or conversion of a well requires filing of ACO-2 within 120 days from commencement date of such work.


All requirements of the statutes, rules and regulations promulgated to regulate the oil and gas industry have been fully complied with and the statements herein are complete and correct to the best of my knowledge.

Signature Beverly J. Williams  
Title Engineering Technician Date 1-12-90

Subscribed and sworn to before me this 12th day of January 19 90.


Date Commission Expires \_\_\_\_\_

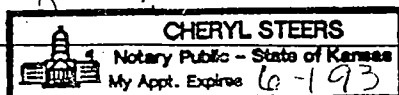

**K.C.C. OFFICE USE ONLY**  
F  Letter of Confidentiality Attached  
C  Wireline Log Received  
C  Drillers Timelog Received  
Distribution  
 KCC  SWD/Rep  NGPA  
 KGS  Plug  Other  
(Specify)

SIDE TWO

Operator Name APX Corporation Lease Name Barrett "A" Well # 1H  
 Sec. 31 Twp. 33S Rge. 34  East  West  
 County Seward

INSTRUCTIONS: Show important tops and base of formations penetrated. Detail all cores. Report all drill stem tests giving interval tested, time tool open and closed, flowing and shut-in pressures, whether shut-in pressure reached static level, hydrostatic pressures, bottom hole temperature, fluid recovery, and flow rates if gas to surface during test. Attach extra sheets if more space is needed. Attach copy of log.

Drill Stem Tests Taken  Yes  No  
 (Attach Additional Sheets.)  
 Samples Sent to Geological Survey  Yes  No  
 Cores Taken  Yes  No  
 Electric Log Run  Yes  No  
 (Submit Copy.)

Name	Formation Description	
	<input checked="" type="checkbox"/> Log	<input type="checkbox"/> Sample
	Top	Bottom
Blaine	1140	1164
Cedar Hills	1192	1348
Stone Corral	1666	1730
Chase	2684	Not Logged
Council Grove	NA	NA
TD		2885

**CASING RECORD**  New  Used  
 Report all strings set-conductor, surface, intermediate, production, etc.

Purpose of String	Size Hole Drilled	Size Casing Set (In O.D.)	Weight Lbs./Ft.	Setting Depth	Type of Cement	# Sacks Used	Type and Percent Additives
Surface	12 1/4	8 5/8	24.0	706	Poz & Common	275	2% CC
Production	7 7/8	5 1/2	14.0	2882	Class "C"	150 235	3% CC 20% DCD 10% DCD

Shots Per Foot	PERFORATION RECORD Specify Footage of Each Interval Perforated	Acid, Fracture, Shot, Cement Squeeze Record (Amount and Kind of Material Used)	Depth
2	2760-2800	A/2000 gals 15% fe acid. A/ 17,600 gals 50% N2. A/5000 gals 50% N2	2760-2800
2	2712-50, 2684-2690	A/2200 gals 15% fe acid. A/ 17600 gals 50% N2. A/5000 gals 50%N2	2684-2750

**TUBING RECORD** Size \_\_\_\_\_ Set At \_\_\_\_\_ Packer At \_\_\_\_\_ Liner Run  Yes  No

Date of First Production SI WO PL Producing Method  Flowing  Pumping  Gas Lift  Other (Explain)  
 Estimated Production Per 24 Hours  
 Oil Bbls. Gas Mcf Water Bbls. Gas-Oil Ratio Gravity  
 360 @ 80 psi

Disposition of Gas:  Vented  Sold  Used on Lease (If vented, submit ACO-18.)  
 METHOD OF COMPLETION:  Open Hole  Perforation  Dually Completed  Commingled  
 Other (Specify) \_\_\_\_\_  
 Production Interval: 2684-2800  
O.A.