


STATE OF KANSAS
STATE CORPORATION COMMISSION

WELL PLUGGING RECORD

Give All Information Completely
Make Required Affidavit
Mail or Deliver Report to
Conservation Division
State Corporation Comm.
245 North Water
Wichita, KS 67202

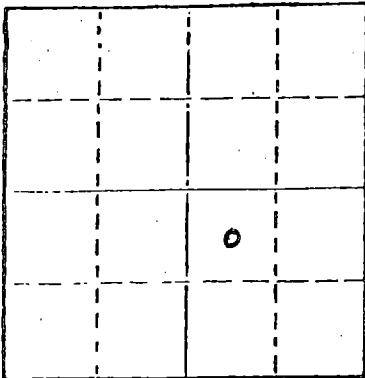

Locate well correctly on above
Section Plat

SEWARD County. Sec. 22 Twp. 33 Rge. 32 NE/W
Location as "NE/CNW $\frac{1}{4}$ SW $\frac{1}{4}$ " or footage from lines
1980' FFSL 1980' FFEL ?
Lease Owner Arkalon Grazing Association
Lease Name Arkalon Well No. 2-22
Office Address 7200 W. 13th Suite 8 Wichita, Ks. 67212
Character of Well (Completed as Oil, Gas or Dry Hole)

DRY HOLE
Date Well completed 05/03/ 1985
Application for plugging filed BY TELEPHONE 1985
Application for plugging approved BY TELEPHONE 1985
Plugging commenced 05/03/ 1985
Plugging completed 05/03 1985
Reason for abandonment of well or producing formation

DRY HOLE
If a producing well is abandoned, date of last production
19

Was permission obtained from the Conservation Division or
its agents before plugging was commenced? YES

Name of Conservation Agent who supervised plugging of this well (316) 225-0596
Producing formation _____ Depth to top _____ Bottom _____ Total Depth of Well 6200'
Show depth and thickness of all water, oil and gas formations.

OIL, GAS OR WATER RECORDS

CASING RECORD

FORMATION	CONTENT	FROM	TO	SIZE	PUT IN	PULLED OUT

Describe in detail the manner in which the well was plugged, indicating where the mud fluid was placed and the method or methods used in introducing it into the hold. If cement or other plugs were used, state the character of same and depth placed, from _____ feet to _____ feet for each plug set. Set 100 sk(60/40 poz @ 14# Gal.) at 3300' displace with 37 bbls. Mud. Set 50 sk plug at 1480' displace with 15 bbls. Mud. Set 40 sk plug at 700' displace with 7.5 bbls. Mud. Top plug 3'-40' Rat hole 15 sacks. Mouse hole 10 sacks.

RECEIVED
STATE CORPORATION COMMISSION

MAY 22 1985

CONSERVATION DIVISION
Wichita, Kansas

(If additional description is necessary, use BACK of this sheet)

Name of Plugging Contractor Halliburton Services

STATE OF KANSAS COUNTY OF SEWARD, ss.
BENNY GREEN (employee of owner) or (XXXXXXXXXXXXXXXXXXXX)
of the above-described well, being first duly sworn on oath, says: That I have knowledge of the facts, statements, and matters herein contained and the log of the above-described well as filed and that the same are true and correct. So help me God.

(Signature) Benny Green
7200 W. 13th St Suite 8 Wichita, Ks. 67212
(Address)

SUBSCRIBED AND SWORN TO before me this 20th day of May, 1985

Carla M. Parker
Notary Public.

My commission expires 01/09/89

