


STATE OF KANSAS
STATE CORPORATION COMMISSION

Form CP-4

Give All Information Completely
Make Required Affidavit
Mail or Deliver Report to:
Conservation Division
State Corporation Commission
P. O. Box 17027
Wichita, Kansas 67217
NORTH

WELL PLUGGING RECORD

Seward County, Sec. 24 Twp. 33S Rge. (E) 32 (W)
Location as "NE/CNWxSWx" or footage from lines 1320' FNL & 1220' FEL
Lease Owner CIG Exploration, Inc.
Lease Name Winchell Well No. 1
Office Address 415 W. 8th St.-Suite 300, Amarillo, Texas 79101
Character of Well (completed as Oil, Gas or Dry Hole) Dry Hole
Date well completed 9-1 19 74
Application for plugging filed 9-1 19 74
Application for plugging approved 9-1 19 74
Plugging commenced 9-2 19 74
Plugging completed 9-2 19 74
Reason for abandonment of well or producing formation Dry Hole

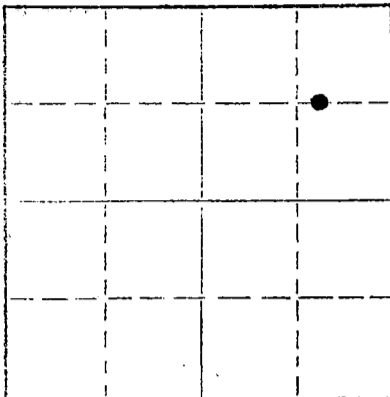

Locate well correctly on above Section Plat

If a producing well is abandoned, date of last production 19
Was permission obtained from the Conservation Division or its agents before plugging was commenced? Yes

Name of Conservation Agent who supervised plugging of this well E. Eves
Producing formation None Depth to top Bottom Total Depth of Well 6300 Feet
Show depth and thickness of all water, oil and gas formations.

OIL, GAS OR WATER RECORDS

CASING RECORD

FORMATION	CONTENT	FROM	TO	SIZE	PUT IN	PULLED OUT
Krider	Salt water	2528	4372	8-5/8	1422	None
Lansing	"	4372	5118			
Marmaton	"	5118	5161			
Morrow	"	5161	5690			
Chester	"	5690	6000			
St. Gen.	"	6000	6132			
St. Louis	"	6132	6300			

Describe in detail the manner in which the well was plugged, indicating where the mud fluid was placed and the method or methods used in introducing it into the hole. If cement or other plugs were used, state the character of same and depth placed, from feet to feet for each plug set.

Hole was loaded w/drlg mud. Spotted 35 sx cement from 1000'-900' & 15 sx 45'-0'.

RECEIVED
STATE CORPORATION COMMISSION

JAN 16 1975

CONSERVATION DIVISION
Wichita, Kansas

(If additional description is necessary, use BACK of this sheet)

Name of Plugging Contractor Service Drilling Company, Tulsa, Oklahoma
Address Halliburton

STATE OF TEXAS COUNTY OF POTTER, ss.

J. D. Stewart, Jr. (employee of owner) or (owner or operator) of the above-described well, being first duly sworn on oath, says: That I have knowledge of the facts, statements, and matters herein contained and the log of the above-described well as filed and that the same are true and correct. So help me God.

(Signature) J. D. Stewart, Jr.
415 W. 8th St.-Suite 300, Amarillo, Texas 79101
(Address)

SUBSCRIBED AND SWORN TO before me this 13th day of January, 19 75

Patricia Marx

My commission expires June 1, 1975

Notary Public.