


WELL PLUGGING RECORD

Give All Information Completely
Make Required Affidavit
Mail or Deliver Report to:
Conservation Division
State Corporation Commission
211 No. Broadway
Wichita, Kansas

Seward County, Sec. 26 Twp. 33S Rge. (E) 32 (W)

Location as "NE/CNW%SW%" or footage from lines C NW SE
Lease Owner Whitehall Oil Company, Inc.
Lease Name J. E. ALEXANDER Well No. 1
Office Address 900 Vaughn Building, Dallas 1, Texas
Character of Well (completed as Oil, Gas or Dry Hole) Dry Hole
Date well completed September 24 1962
Application for plugging filed September 24 1962
Application for plugging approved September 24 1962
Plugging commenced September 24 1962
Plugging completed September 24 1962
Reason for abandonment of well or producing formation No commercial zones

NORTH

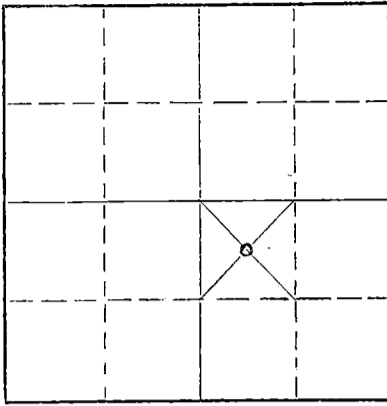

Locate well correctly on above
Section Plat

If a producing well is abandoned, date of last production - - - 19 - -
Was permission obtained from the Conservation Division or its agents before plugging was commenced? Yes

Name of Conservation Agent who supervised plugging of this well Hugh Scott
Producing formation - - - Depth to top - - - Bottom - - - Total Depth of Well 6175' Feet
Show depth and thickness of all water, oil and gas formations.

OIL, GAS OR WATER RECORDS

CASING RECORD

FORMATION	CONTENT	FROM	TO	SIZE	PUT IN	PULLED OUT
				8-5/8"	2340'	0

Describe in detail the manner in which the well was plugged, indicating where the mud fluid was placed and the method or methods used in introducing it into the hole. If cement or other plugs were used, state the character of same and depth placed, from - - - feet to - - - feet for each plug set.

Cement was pumped in hole through the drill pipe and one 35-sack plug was placed from 700' to 583', and a second plug of 15 sacks was placed from 45' to the surface of the ground. The remainder of the hole was filled with 9.4#/gallon drilling mud.

RECEIVED
STATE CORPORATION COMMISSION
SEP 27 1962

CONSERVATION DIVISION
Wichita, Kansas

(If additional description is necessary, use BACK of this sheet)

Name of Plugging Contractor Halliburton Company
Address Duncan, Oklahoma

STATE OF TEXAS, COUNTY OF DALLAS, ss.
Dale O. Chase (employee of owner) or ~~XXXXXXXXXX~~ of the above-described well, being first duly sworn on oath, says: That I have knowledge of the facts, statements, and matters herein contained and the log of the above-described well as filed and that the same are true and correct. So help me God.

(Signature) Dale O. Chase
900 Vaughn Building, Dallas 1, Texas
(Address)

SUBSCRIBED AND SWORN TO before me this 25th day of September, 19 62

My commission expires 6/1/63

Notary Public.

