


STATE OF KANSAS
STATE CORPORATION COMMISSION

WELL PLUGGING RECORD

Give All Information Completely
Make Required Affidavit
Mail or Deliver Report to:
Conservation Division
State Corporation Commission
211 No. Broadway
Wichita, Kansas

NORTH

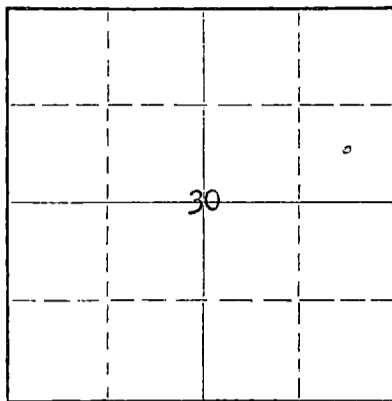

Locate well correctly on above
Section Plat

Seward County, Sec. 30 Twp. 33S Rge. (E) 32(W)

Location as "NE/CNW/SW" or footage from lines G SW/4 NE/4
Lease Owner Cities Service Oil Company
Lease Name Salley "G" Well No. 1
Office Address Box 6 Liberal, Kansas
Character of Well (completed as Oil, Gas or Dry Hole) Dry Hole
Date well completed 2-7- 19 64
Application for plugging filed 2-6- 19 64
Application for plugging approved 2-7- 19 64
Plugging commenced 2-6- 19 64
Plugging completed 2-7- 19 64
Reason for abandonment of well or producing formation Non-productive - Dry

If a producing well is abandoned, date of last production 19
Was permission obtained from the Conservation Division or its agents before plugging was commenced? Yes

Name of Conservation Agent who supervised plugging of this well Mr. Hugh Scott
Producing formation _____ Depth to top _____ Bottom _____ Total Depth of Well 6500 Feet
Show depth and thickness of all water, oil and gas formations.

OIL, GAS OR WATER RECORDS

CASING RECORD

FORMATION	CONTENT	FROM	TO	SIZE	PUT IN	PULLED OUT
Hugoton	Possible gas or water	2606	2745	8 5/8"	1576	None

Describe in detail the manner in which the well was plugged, indicating where the mud fluid was placed and the method or methods used in introducing it into the hole. If cement or other plugs were used, state the character of same and depth placed, from _____ feet to _____ feet for each plug set.

Hvy mud in bottom 6500' to 2750'
 Spotted 50 sx cement thru drill pipe 2750-2580'
 Hvy mud " " " 2580-1425'
 25 sx cement " " " 1425-1330'
 Hvy mud " " " 1330- 700'
 35 sx cement " " " 700- 570'
 Hvy mud " " " 570- 40'
 15 sx cement " " " 40- 0'

RECEIVED
STATE CORPORATION COMMISSION
FEB 17 1964
CONSERVATION DIVISION
Wichita, Kansas

(If additional description is necessary, use BACK of this sheet)
Name of Plugging Contractor Halliburton Co.
Address Duncan, Oklahoma

STATE OF KANSAS, COUNTY OF SEWARD, ss.
A. P. Coe (employee of owner) or (owner or operator) of the above-described

well, being first duly sworn on oath, says: That I have knowledge of the facts, statements, and matters herein contained and the log of the above-described well as filed and that the same are true and correct. So help me God.

(Signature) [Signature] A.P. Coe
Box 6 - Liberal, Kansas
(Address)

SUBSCRIBED AND SWORN TO before me this 10th day of February, 19 64

My commission expires 11-5-66
Calvin Lindsey Notary Public.



ROTARY DRILLING LOG

OWNER: Cities Service Oil Company CASING: Set 8 5/8" 2 1/2" casing @
 CONTRACTOR: Lohmann-Johnson Drilling Co. 1574', cemented with 625 sx
 LEASE: Salley "G" #1 common cement
 LOCATION: C SW NE Section 30-33S-32W
 Seward County, Kansas

0 - 880	Surface Sand
880 - 1580	Sand & Shale
1580 - 2332	Red Bed & Shale
2332 - 2943	Lime & Shale
2943 - 3068	Lime
3068 - 3298	Lime & Shale
3298 - 3413	Lime & Chalk
3413 - 3445	Lime
3445 - 3667	Lime & Shale
3667 - 3890	Lime
3890 - 4039	Lime & Shale
4039 - 4101	Lime
4101 - 4237	Shale & Lime
4237 - 4366	Lime & Shale
4366 - 4434	Lime
4434 - 4585	Lime & Shale
4585 - 4670	Lime
4670 - 4820	Lime & Shale
4820 - 4874	Lime
4874 - 4941	Lime & Shale
4941 - 5192	Lime
5192 - 5259	Lime & Shale
5259 - 5480	Lime
5480 - 6064	Shale & Lime
6064 - 6500	Lime
6500	Rotary Total Depth
	D & A

RECEIVED
STATE CORPORATION COMMISSION

FEB 17 1964

CONSERVATION DIVISION
Wichita, Kansas

We certify that the above log is true and correct to the best of our knowledge and belief.

CITIES SERVICE OIL COMPANY

BY



A. P. Coe
District Superintendent