


STATE OF KANSAS
STATE CORPORATION COMMISSION

WELL PLUGGING RECORD

Give All Information Completely
Make Required Affidavit
Mail or Deliver Report to:
Conservation Division
State Corporation Commission
211 No. Broadway
Wichita, Kansas

Seward County. Sec. 31 Twp. 33 Rge. 32 (E) (W)
Location as "NE/CNW/SW" or footage from lines 100' N. of Center of W/2
Lease Owner Anadarko Production Company
Lease Name Jacquart Well No. 1-31
Office Address Box 351, Liberal, Kansas
Character of Well (completed as Oil, Gas or Dry Hole) Dry Hole
Date well completed May 7 19 60
Application for plugging filed May 7 19 60
Application for plugging approved May 7 19 60
Plugging commenced May 7 19 60
Plugging completed May 7 19 60
Reason for abandonment of well or producing formation Dry Hole

NORTH

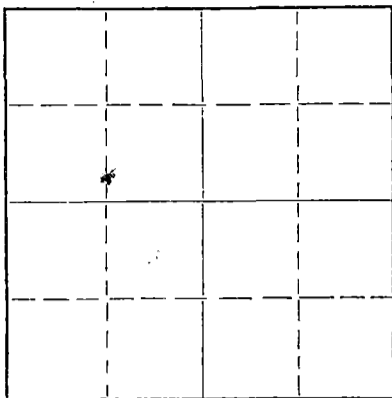

Locate well correctly on above
Section Plat

If a producing well is abandoned, date of last production _____ 19____
Was permission obtained from the Conservation Division or its agents before plugging was commenced? Yes

Name of Conservation Agent who supervised plugging of this well W. L. Lackamp
Producing formation _____ Depth to top _____ Bottom _____ Total Depth of Well 2717 Feet
Show depth and thickness of all water, oil and gas formations.

OIL, GAS OR WATER RECORDS

CASING RECORD

FORMATION	CONTENT	FROM	TO	SIZE	PUT IN	PULLED OUT
				8 5/8"	604	None
				4 1/2"	2716	385

Describe in detail the manner in which the well was plugged, indicating where the mud fluid was placed and the method or methods used in introducing it into the hole. If cement or other plugs were used, state the character of same and depth placed, from _____ feet to _____ feet for each plug set.

Pumped 150 sacks Cement and Plug to 2287 feet, filled with heavy mud to 385 feet, spotted 40 sacks cement, filled hole to 25 feet with heavy mud and spotted 10 sacks cement to 5 feet of surface and cut off casing.

RECEIVED
STATE CORPORATION COMMISSION
JUN 7 1960
CONSERVATION DIVISION
Wichita, Kansas

(If additional description is necessary, use BACK of this sheet)

Name of Plugging Contractor Andrews Well Servicing Company, Inc.
Address 811 North Roosevelt, Liberal, Kansas

STATE OF Kansas, COUNTY OF Seward, ss.
Anadarko Production Company (employee of owner) or (owner or operator) of the above-described well, being first duly sworn on oath, says: That I have knowledge of the facts, statements, and matters herein contained and the log of the above-described well as filed and that the same are true and correct. So help me God.

(Signature) R. L. Shields, Manager
Drilling and Production
Box 351, Liberal, Kansas
(Address)

SUBSCRIBED AND SWORN TO before me this 2nd day of June 1960

MY COMMISSION EXPIRES DEC. 9, 1961
My commission expires _____

S. J. Blair
Notary Public.



15-175-00225-0000

DRILLER'S LOG

WELL NAME: Jacquart 1-31; COMPANY OPERATING: Anadarko Production Company
 ADDRESS of COMPANY: Box 351, Liberal, Kansas

WELL LOCATION: 1/4 NE 1/4 SW 1/4,
2740 ft. North of South line,
1320 ft. East of West line; Sec. 31, Twp. 33, Rge. 32, Seward County, Kansas

DRILLING STARTED April 14, 1960; DRILLING COMPLETED April 27, 1960
 WELL COMPLETED May 7, 1960; WELL CONNECTED _____, 19____

ELEVATION: 2816 ft. Ground Level; CHARACTER OF WELL (Oil, Gas, or Dry Hole) Dry Hole

OIL OR GAS SANDS OR ZONES - PERFORATIONS - ACIDIZING AND FRACTURING INFORMATION					
Name	From	To	No. of Shots	Gallons Used	Kind Used
Winfield	2677	2682	20	2000	15%
Winfield	2657	2670	26	10000 Gal. Gel	Acid
Herrington	2634	44	20	10000 Lbs. Sand	
				1000	15%

CASING RECORD

Size	Amount Set	Sacks of Cement	Amount Pulled
8 5/8"	604	375	None
4 1/2"	2716	135	385

FORMATION RECORD

Formation	Top	Bottom	Formation	Top	Bottom
Surface Sand	0	610			
Red Bed	610	994			
Red Bed and Anhydrite	994	1736			
Red Bed, Anhydrite & Shale	1736	2285			
Anhydrite	2285	2441			
Anhydrite and Lime	2441	2609			
Dolomite	2609	2717			
Total Depth	2717				

RESULTS of INITIAL PRODUCTION TEST: _____

DRILLER'S LOG








FORMATION RECORD

Formation	Top	Bottom	Formation	Top	Bottom

STATE CORPORATION COMMISSION

JUN 7 1960

CONSERVATION DIVISION
 WICHITA, Kansas

RESULTS of INITIAL PRODUCTION TEST: _____