


Give All Information Completely
Make Required Affidavit
Mail or Deliver Report to:
Conservation Division
State Corporation Commission
211 No. Broadway
Wichita, Kansas

WELL PLUGGING RECORD

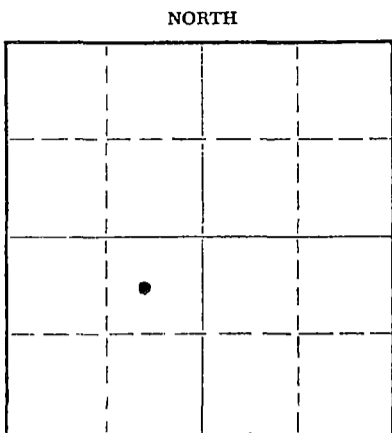

Locate well correctly on above
Section Plat

Seward County. Sec. 35 Twp. 33S Rge. (E) 32 (W)
Location as "NE/CNWxSWx" or footage from lines Approx. C-NE-SW
Lease Owner Petroleum Inc.
Lease Name Alexander Unit Well No. 1
Office Address P.O. Box 1255 Liberal, Kansas
Character of Well (completed as Oil, Gas or Dry Hole) Dry Hole
Date well completed 10-5-65 19
Application for plugging filed 10-5-65 19
Application for plugging approved 10-6-65 19
Plugging commenced 10-5-65 19
Plugging completed 10-5-65 19
Reason for abandonment of well or producing formation Dry

If a producing well is abandoned, date of last production _____ 19____
Was permission obtained from the Conservation Division or its agents before plugging was commenced? Yes

Name of Conservation Agent who supervised plugging of this well Hugh Scott
Producing formation None Depth to top _____ Bottom _____ Total Depth of Well 6141 Feet
Show depth and thickness of all water, oil and gas formations.

OIL, GAS OR WATER RECORDS

CASING RECORD

FORMATION	CONTENT	FROM	TO	SIZE	PUT IN	PULLED OUT
				8-5/8"	1458'	None

Describe in detail the manner in which the well was plugged, indicating where the mud fluid was placed and the method or methods used in introducing it into the hole. If cement or other plugs were used, state the character of same and depth placed, from _____ feet to _____ feet for each plug set.

Mudded up with heavy mud from 6141' to 700'. Dumped 35 sacks cement from 700' to 595'.
Mudded up with heavy mud from 595' to 45'. Dumped 15 sacks cement from 45' to base
of well cellar.

RECEIVED
OCT 27 1965

CONSERVATION DIVISION
STATE CORPORATION COMMISSION

(If additional description is necessary, use BACK of this sheet)
Name of Plugging Contractor Garvey Drilling Co.
Address R.R. # 2 Great Bend, Kansas

STATE OF Kansas, COUNTY OF Seward, ss.
Harold L. Young (employee of owner) ~~owner or operator~~ of the above-described

well, being first duly sworn on oath, says: That I have knowledge of the facts, statements, and matters herein contained and the log of the above-described well as filed and that the same are true and correct. So help me God.

(Signature) Harold L. Young
P.O. Box 1255 Liberal, Kansas
(Address)

SUBSCRIBED AND SWORN TO before me this 26th day of October, 19 65
Richard D. Junk
Notary Public.

My commission expires January 20, 1969

WELL LOG

15-175-30079-0000

COMPANY Petroleum, Inc.

SEC. 35 T. 33S R. 32W

FARM Alexander Unit NO. 1

LOC. 50' E of C-NE-SW


TOTAL DEPTH 6141'

COUNTY Seward

COMM. 9-16-65

COMP. 10-5-65

CONTRACTOR Garvey Drilling Company

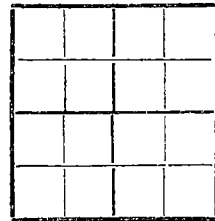

CASING 8 5/8" @ 1458' w/800 sx

ELEVATION

PRODUCTION D & A

FIGURES INDICATE BOTTOM OF FORMATIONS

- 590' Sand and Clay
- 845' Red Bed
- 890' Gyp
- 1230' Sand and Shale
- 1455' Red Bed and Shells
- 1458' Anhydrite
- 1550' Anhydrite and Shale
- 1970' Red Bed
- 2305' Shale and Lime
- 3365' Lime and Shale
- 3455' Lime
- 3784' Lime and Shale
- 4200' Shale and Lime
- 4360' Lime and Shale
- 4958' Lime
- 5080' Lime and Shale
- 5207' Lime
- 5240' Lime and Chert
- 5440' Lime
- 5570' Lime and Shale
- 5624' Lime
- 5750' Lime and Shale
- 5800' Shale and Lime
- 5825' Lime, Shale, and Sand
- 5891' Lime, Sand and Shale
- 6035' Lime and Shale
- 6070' Lime
- 6133' Lime and Shale
- 6141' Lime
- 6141' RTD

RECEIVED
STATE CORPORATION COMMISSION

OCT 27 1965

CONSERVATION DIVISION
Wichita, Kansas

State of Kansas }
County of Barton } SS

I, Sam N. Stephens of Garvey Drilling Company

upon oath state the above and foregoing is a true and correct copy of the log of the Alexander Unit #1 well.

Subscribed and sworn to before me this 23rd day of October 19 65

My Commission Expires: May 28, 1969

Richard H. Dumble
NOTARY PUBLIC