


STATE OF KANSAS  
STATE CORPORATION COMMISSION

WELL PLUGGING RECORD

Give All Information Completely  
Make Required Affidavit  
Mail or Deliver Report to  
Conservation Division  
State Corporation Comm.  
245 North Water  
Wichita, KS 67202

Seward County, Sec. 35 Twp. 33S Rge. 32 ~~XX~~/W  
Location as "NE/CNW $\frac{1}{4}$ SW $\frac{1}{4}$ " or footage from lines  
960' FNL & 2130' FEL  
Lease Owner Mesa Petroleum  
Lease Name Arkalon Well No. 1-35  
Office Address Box 1578, Liberal, KS 67901  
Character of Well (Completed as Oil, Gas or Dry Hole)  
Dry hole  
Date Well completed 1-22-19 80  
Application for plugging filed 19  
Application for plugging approved 19  
Plugging commenced 1-24 19 80  
Plugging completed 1-24 10:00AM 19 80  
Reason for abandonment of well or producing formation

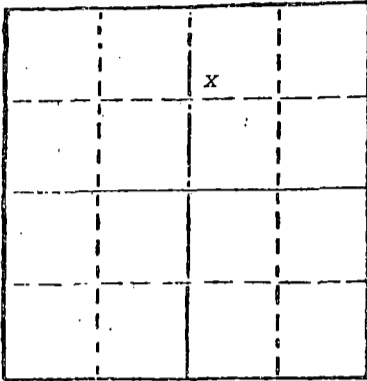

Locate well correctly on above  
Section Plat

If a producing well is abandoned, date of last production 19

Was permission obtained from the Conservation Division or  
its agents before plugging was commenced? Yes

Name of Conservation Agent who supervised plugging of this well Clarence Thomas  
Producing formation Depth to top Bottom Total Depth of Well 5930  
Show depth and thickness of all water, oil and gas formations.

OIL, GAS OR WATER RECORDS

CASING RECORD

FORMATION	CONTENT	FROM	TO	SIZE	PUT IN	PULLED OUT
				8 5/8"	1502'	none

Describe in detail the manner in which the well was plugged, indicating where the mud fluid  
was placed and the method or methods used in introducing it into the hold. If cement or other  
plugs were used, state the character of same and depth placed, from feet to  
feet for each plug set.

Plugged well as follows:  
50 sacks 1500 ; 25 sacks 750  
10 sacks 40-0'; 5 sacks rathole and 5 sacks mousehole  
cutoff pipe and welded on ID cap  
Job complete @ 10:00AM on 1-24-80

RECEIVED  
STATE CORPORATION COMMISSION  
JAN 25 1980  
CONSERVATION DIVISION  
Wichita, Kansas

(If additional description is necessary, use BACK of this sheet)

Name of Plugging Contractor Halliburton

STATE OF Kansas COUNTY OF Seward, ss.  
Ned E. Lowry (employee of owner) or (owner or operator)  
of the above-described well, being first duly sworn on oath, says: That I have knowledge of  
the facts, statements, and matters herein contained and the log of the above-described well  
as filed and that the same are true and correct. So help me God.

(Signature) Ned E. Lowry  
Box 1578, Liberal, KS 67901  
(Address)

SUBSCRIBED AND SWORN TO before me this 24th day of January, 19 80

My commission expires February 26, 1983

Denise Geist  
Notary Public.  
DENISE GEIST  
STATE NOTARY PUBLIC  
SEWARD COUNTY, KANSAS  
MY ADPT. EXPIRES 2-26-83

STATE OF KANSAS  
STATE CORPORATION COMMISSION

WELL PLUGGING RECORD

Give All Information Completely  
Make Required Affidavit  
Mail or Deliver Report to  
Conservation Division  
State Corporation Comm.  
245 North Water  
Wichita, KS 67202

Seward County, Sec. 35 Twp. 33S Rge. 32W E/W  
Location as "NE/CNW $\frac{1}{4}$ SW $\frac{1}{4}$ " or footage from lines  
660' FNL & 1980' FEL

Lease Owner Mesa Petroleum Co.  
Lease Name Arkalon Well No. 1-35

Office Address 50 Penn Place, Suite 1200, Okla. City  
Character of Well (Completed as Oil, Gas or Dry Hole)  
Dry Hole

Date Well completed January 24, 1980

Application for plugging filed 19

Application for plugging approved 19

Plugging commenced January 24, 1980

Plugging completed January 24, 1980

Reason for abandonment of well or producing formation  
Dry Hole

If a producing well is abandoned, date of last production  
19

Was permission obtained from the Conservation Division or  
its agents before plugging was commenced? Yes

Name of Conservation Agent who supervised plugging of this well Clarence Thomas, Garden City

Producing formation \_\_\_\_\_ Depth to top \_\_\_\_\_ Bottom \_\_\_\_\_ Total Depth of Well 15934'

Show depth and thickness of all water, oil and gas formations.

OIL, GAS OR WATER RECORDS

CASING RECORD

FORMATION	CONTENT	FROM	TO	SIZE	PUT IN	PULLED OUT
	Surface	0	1502'	8-5/8"	1502'	None
	Casing					

Describe in detail the manner in which the well was plugged, indicating where the mud fluid was placed and the method or methods used in introducing it into the hold. If cement or other plugs were used, state the character of same and depth placed, from \_\_\_\_\_ feet to \_\_\_\_\_ feet for each plug set.

Plugged Hole w/50 sax Cement @ 1500',  
25 sax cement @ 750', 10 sax cement  
0 to 33', 5 sax cement in rat hole.  
Job completed @ 10:00 A.M.

(If additional description is necessary, use BACK of this sheet)

Name of Plugging Contractor Halliburton

STATE OF KANSAS COUNTY OF SEDGWICK, ss.

John R. Bartholomew of Sage Drilling Co. ~~(signature)~~, being first duly sworn on oath, says: That I have knowledge of the facts, statements, and matters herein contained and the log of the above-described well as filed and that the same are true and correct. So help me God.

(Signature) John R. Bartholomew  
222 Sutton Place, Wichita, Ks. 67202  
(Address)



My commission expires November 26, 1982.

Louise K. Whitted - Notary Public.

RECEIVED  
STATE CORPORATION COMMISSION

FEB - 8 1980

CONSERVATION DIVISION  
WICHITA, KANSAS

15-175-20441-0000

DRILLERS LOG

ARKALON NO. 1-35

CASING RECORD:	OPERATOR: Mesa Petroleum Co.	DESCRIPTION:
8-5/8" set @ 1502' w/825 sax cement	CONTRACTOR: Sage Drilling Co., Inc.	660' FNL & 1980' FEL of Sec. 35-33S-32W Seward County, Oklahoma.
TOTAL DEPTH: 5934'	COMMENCED: January 10, 1980	
	COMPLETED: January 24, 1980	

<u>FORMATION</u>	<u>FROM</u>	<u>TO</u>	<u>REMARKS</u>
Sand & Red Bed	0	1502	
Red Bed	1502	2260	
Red Bed, Shale & Lime	2260	2460	
Shale & Lime	2460	2650	
Lime & Shale	2650	3055	
Shale & Lime	3055	3273	
Lime & Shale	3273	3698	
Shale & Lime	3698	3865	
Lime & Shale	3865	4300	Ran DST #1
Shale & Lime	4300	4443	
Lime & Shale	4443	5550	
Shale & Lime	5550	5663	
Lime & Shale	5663	5770	Ran DST #2
Lime & Shale	5770	5934	Logged Hole, D. & A.

I certify that this is a true and correct copy of the log on the above captioned well to the best of my knowledge.

SAGE DRILLING CO., INC.

By John R. Bartholomew  
John R. Bartholomew



Subscribed and sworn to before me this 29th day of January, 1980.

RECEIVED  
 FEB - 6 1980  
Louise K. Whitted  
 Louise K. Whitted, Notary Public  
 CONSERVATION DIVISION  
 Wichita, Kansas

My Commission expires:  
November 26, 1982.