


STATE OF KANSAS  
STATE CORPORATION COMMISSION

WELL PLUGGING RECORD

Give All Information Completely  
Make Required Affidavit  
Mail or Deliver Report to  
Conservation Division  
State Corporation Comm.  
245 North Water  
Wichita, KS 67202

~~Sedgwick~~ Pratt County. Sec. 18 Twp. 28S Rge. 11 E/W  
Location as "NE/CNW $\frac{1}{4}$ SW $\frac{1}{4}$ " or footage from lines  
SE/4 NE/4 NW/4

Lease Owner Longhorn Energy Res., Inc.  
Lease Name Lunt Well No. 1  
Office Address P.O. Box 1314, Great Bend, KS 67530  
Character of Well (Completed as Oil, Gas or Dry Hole) Dry Hole  
Date Well completed September 3 19 82  
Application for plugging filed September 3 19 82  
Application for plugging approved September 3 19 82  
Plugging commenced September 3 19 82  
Plugging completed September 3 19 82  
Reason for abandonment of well or producing formation \_\_\_\_\_

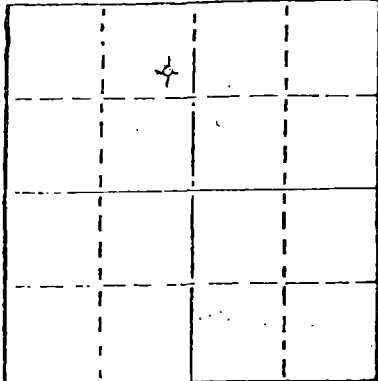

Locate well correctly on above Section Plat

If a producing well is abandoned, date of last production 19

Was permission obtained from the Conservation Division or its agents before plugging was commenced? Yes

Name of Conservation Agent who supervised plugging of this well Maurice Leslie  
Producing formation \_\_\_\_\_ Depth to top \_\_\_\_\_ Bottom \_\_\_\_\_ Total Depth of Well \_\_\_\_\_  
Show depth and thickness of all water, oil and gas formations.

RTD 3990'

OIL, GAS OR WATER RECORDS

CASING RECORD

FORMATION	CONTENT	FROM	TO	SIZE	PUT IN	PULLED OUT
	Surface	0	416'	8-5/8"	yes	no

Describe in detail the manner in which the well was plugged, indicating where the mud fluid was placed and the method or methods used in introducing it into the hold. If cement or other plugs were used, state the character of same and depth placed, from \_\_\_\_\_ feet to \_\_\_\_\_ feet for each plug set.

1st plug @ 800' w/ 50 sx. 50-50 Poz 2% gel 2%cc  
2nd plug @ 450' w/ 50 sx.  
Bridge plug @ 40' w/ 10 sx.  
10 sx. in rathole, 10 sx. in mousehole, 5 sx. in water well  
Job complete @ 3:30 p.m. 9/3/82

(If additional description is necessary, use BACK of this sheet)

Name of Plugging Contractor Big-H Drilling, Inc.

STATE OF Kansas COUNTY OF Sedgwick, ss.  
Wilber Berg of Big-H Drilling, Inc. (employee of owner) or (owner or operator)  
of the above-described well, being first duly sworn on oath, says: That I have knowledge of the facts, statements, and matters herein contained and the log of the above-described well as filed and that the same are true and correct. So help me God.

(Signature) Wilber Berg  
Big-H Drilling, Inc.  
400 One Main Place, Wichita, KS 67202  
(Address)

SANDRA L. MENDOZA  
STATE NOTARY PUBLIC  
SEDGWICK COUNTY, KANSAS  
MY APPT. EXP. 2/12/82

SWORN TO before me this 7th day of September, 19 82

Sandra L. Mendoza  
Notary Public.

My commission expires 2/12/86

RECEIVED  
STATE CORPORATION COMMISSION

FEB 06 1984

CONSERVATION DIVISION  
Wichita, Kansas